IREDELL COUNTY HEALTH DEPARTMENT

Statesville Office (704) 878-5305 Mooresville Office (704) 660-3625 PERMIT # 211453

IMPROVEMENT PERMIT / AUTHORIZATION TO CONSTRUCT / OPERATION PERMIT / EXISTING SYSTEM

PIN # 4761-37-7591

APPLICANT: LUIS VARGAS APPLICANT ADDRESS: 1020 BETHESDA RD.

SITE ADDRESS: SAME PHONE: 704-437-4583 ALT. PHONE: N/A

SITE DIRECTIONS: 70 E, BETHESDA, ON L

SUBDIVISION: WOODHAVEN SECTION: N/A LOT # 5 LOT AREA: .91 AC DESIGN FLOW: 240 L.T.A.R.: EXISTING

Septic Tank ____ (gal) STB ____ Date ____

Pump Tank EXISTING (gal) PT ____ Date ____

Pump Make ____ Model ____ Serial # ____

Nitrification Fields ____ # Lines ____ Linear Ft: ____

Trench Width EX Max. Trench Bottom Depth EX Gravel Depth 12"

☐ New System ☐ Repair ☐ Expansion System Type: I (II) III IV V VI

System Description: CONVENTIONAL

Repair System Description:

Maintenance Agreement Required: ☐ YES ☒ NO

☒ GRAVITY ☐ PRESSURE

☐ Residence No. Bedrooms 2

☐ Business No. Persons 4

☒ Other No. Employees

☐ Slab ☐ Crawl Space

☐ Basement w/plumbing ☐ Basement w/o plumbing

Water Supply: ☑ Private ☐ Public ☐ Community


Comments / Conditions:

PORCH

INITIAL SITE SKETCH

*SYSTEM APPEARED TO BE FUNCTIONING @ TIME OF INSPECTION

AS BUILT SKETCH

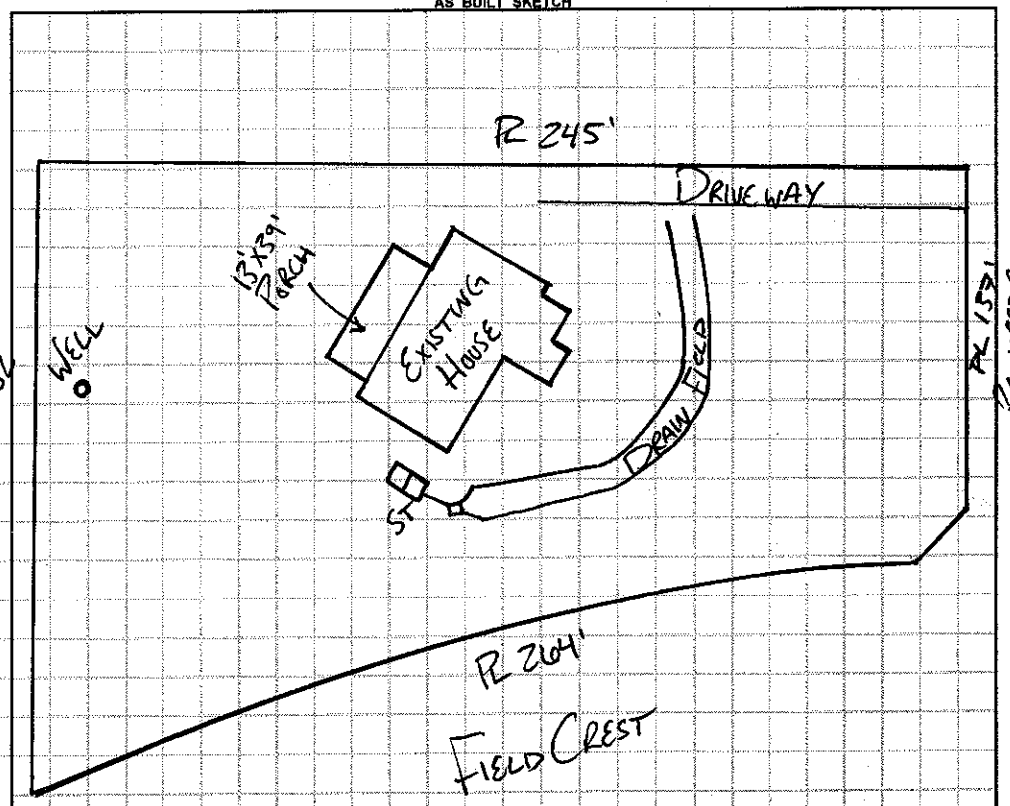

Permit can be suspended or revoked if any false information is supplied toward securing the permit / any unauthorized changes are made to the site / any unauthorized changes are made in the installation of the system. **CONTACT A LOCATOR SERVICE PRIOR TO ANY EXCAVATION**

☐ **IMPROVEMENT PERMIT** *with plat valid without expiration.* ☐ **IMPROVEMENT PERMIT** *with site plan valid for 60 mos.* ☐ **AUTHORIZATION TO CONSTRUCT** *valid for period equal to IMPROVEMENT PERMIT--not to exceed 60 mo.*

Owner / Applicant Signature: LUIS VARGAS Date: 7-10-15 Installed by: ____

IMPROVEMENT PERMIT by: ____ Date: ____ OPERATION PERMIT by: ____ Date: ____

AUTHORIZATION TO CONSTRUCT by: ____ Date: ____ Existing System Inspected by: [signature] Date: 7-1-15

Health Dept. Copy - WHITE Applicant (Final Approval) - YELLOW Applicant (Conditional Approval) - PINK