Pd #175.

9:30

IREDELL COUNTY HEALTH DEPARTMENT

STATESVILLE 704-878-5305 MOORESVILLE 704-664-5281

IMPROVEMENT PERMIT / CERTIFICATE OF COMPLETION / OPERATION PERMIT / EXISTING SYSTEM INSPECTION

PROPERTY DESCRIPTION NO. 22965 DATE 2-29-96 TAX MAP NO. 5B-3-A-20 Watershed: ☐ Yes ☒ No

OWNER OR CONTRACTOR ~~Scott~~ ~~Bruce~~ Ray Turner PHONE: Business _____ Home 528-9913

ADDRESS Rt 1 Box 259-A Troutman N.C.

LOCATION 70E TR Bethesta Church Rd TR Reuben Dr. TL Jeremy Lane 5th lot left

SUBDIVISION Beechwood BLOCK / SECTION II LOT 19+20 LOT AREA ~~1.82 acres~~ SITE CLASS PS DESIGN FLOW 360 L.T.A.R. .3

Septic Tank 1000 Gallons, STB 1794 Date 19+20

Pump Tank _____ Gallons, PT _____ Date 6-17-96

Pump Make: _____ Model _____ Serial No. 3250

Nitrification Field: No. Fields 1 Square Feet 960 Linear Feet ~~360~~

No. Lines 3 Trench Width 36" Max Trench Bottom Depth 36" Gravel Depth N/A

☐ New System ☐ Repair System Type I II III IV V

System Description: Gravity Chambers 11 Panels

Repair System Description: _____

Maintenance Agreement Required: Yes No

☐ Slab ☐ Crawl Space ☐ Basement w/plumbing ☐ Basement wo/plumbing

☐ Home ☐ Mod. Home ☐ Mobile Home ☐ Business ☐ Other


No. Bedrooms 3 No. Bathrooms 2 No. Employees _____

Water Supply: ☒ Individual ☐ Community ☐ Public


Comments

Comments: New owner has lots 19+20 Home + well NOT on site at Time of This inspection

INITIAL SITE SKETCH

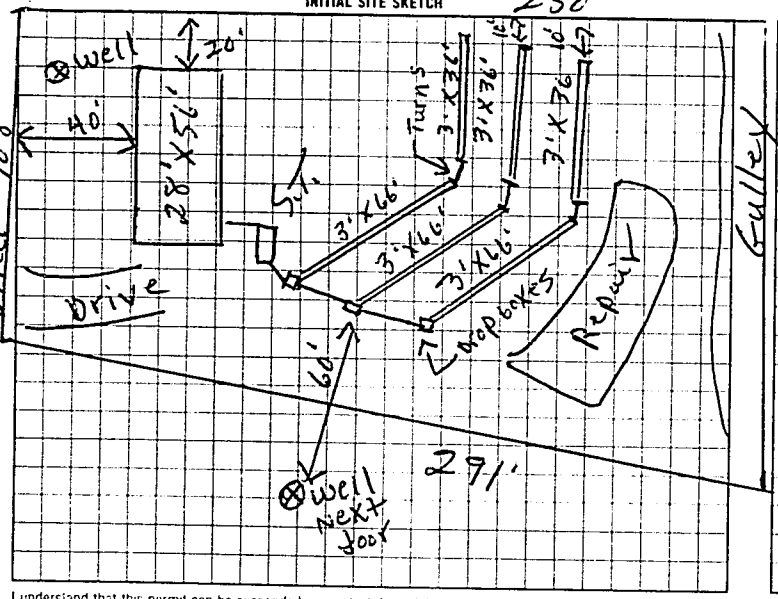

AS BUILT SKETCH

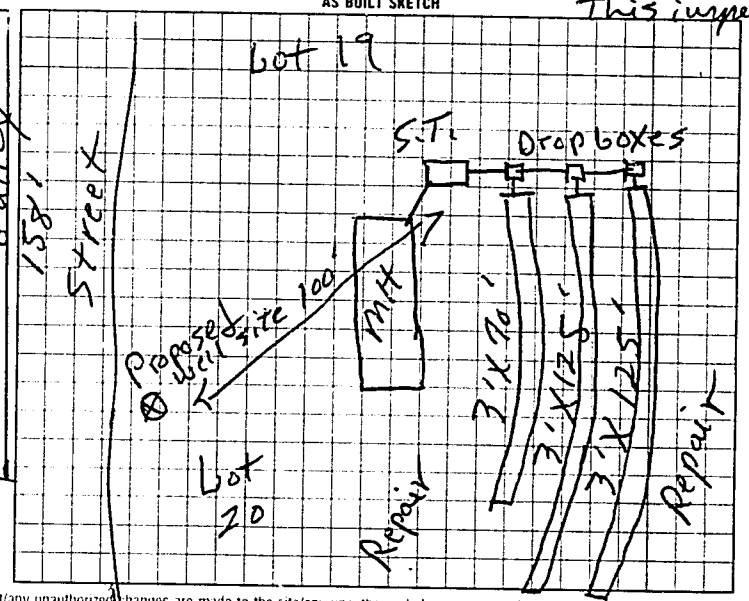

I understand that this permit can be suspended or revoked if any false information is supplied toward securing the permit/any unauthorized changes are made to the site/any unauthorized changes are made in the installation of the system

Signed Ray Turner

Improvement Permit by L.C. Moore date 2-29-96

Existing System Information by L.C. Moore date 2-29-96

Authorization to Construct: Installed by Tim Ammons

Certificate of Completion by _____ date _____

Operation Permit by L.C. Moore date 8-23-96

HEALTH DEPT COPY (WHITE) INSPECTION COPY (FINAL) GREEN OWNER COPY (FINAL) YELLOW INSPECTION COPY (INITIAL) PINK OWNER COPY (INITIAL) GOLD

Authorization to const. EXPIRES 60 mos From issue

129200