48114

IREDELL COUNTY HEALTH DEPARTMENT

STATESVILLE 704-878-5305 MOORESVILLE 704-664-5281

IMPROVEMENT PERMIT / CERTIFICATE OF COMPLETION / OPERATION PERMIT / EXISTING SYSTEM INSPECTION

PROPERTY DESCRIPTION NO. 16485 DATE 6-14-93 TAX MAP NO. 5B-2-B-15

OWNER OR CONTRACTOR Billy M. Dickerson PHONE: Business 597-1831 Home 664 7761

ADDRESS 2751 Kerr Ave Mooresville N.C.

LOCATION 70E TR Bethesda Rd almost to end TR Fieldcrest TR Woodhaven, TR Fieldcrest ct. at end

SUBDIVISION Wood Haven BLOCK / SECTION ____ LOT 18 LOT AREA 1.697 acres SITE CLASS. P.S. L.T.A.R. .14

Water Supply: ☑ Individual ☐ Community ☐ Public

Septic Tank: 1500 Gallons; STB 750 Date 7-5-93

Pump Tank: ____ Gallons; PT ____ Date ____

Nitrification Field: No Fields 1 Square Feet 1200 Linear Feet 400

☑ No Lines 5 Trench Width 36" Trench Depth 24 Gravel Depth 12"

☑ New System ☐ Repair System Type: I (II, III, IV, V, VI)

System Description: Conv. Gravity

Repair System Description: Conv. Pump

Maintenance Agreement Required: ☐ Yes ☑ No

☐ House/Mod. Home ☑ Mobile Home ☐ Business ☐ Other ____

No. Bedrooms 4 No. Bathrooms 2 No. Employees ____

☐ Slab ☑ Crawl Space ☐ Basement w/plumbing ☐ Basement wo/plumbing

Garbage Disposal: ☑ Yes ☐ No

Auto. Dishwasher: ☑ Yes ☐ No

Auto. Washing Machine: ☑ Yes ☐ No


Other ____

Comments Replaces permit Issued 1989 by Darrin Weaver That had Expired


well not located at time of this inspection

locate 100' from existing system

INITIAL SITE SKETCH

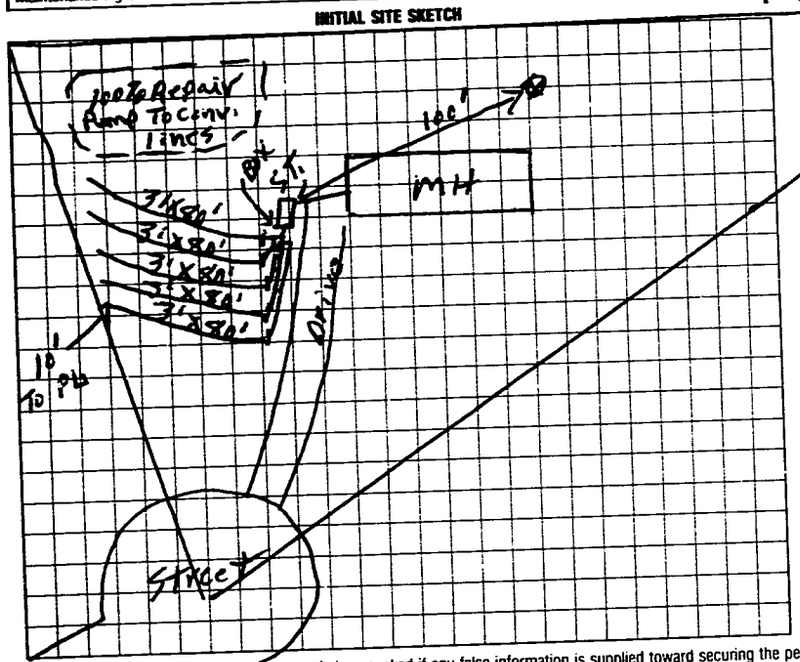

AS BUILT SKETCH

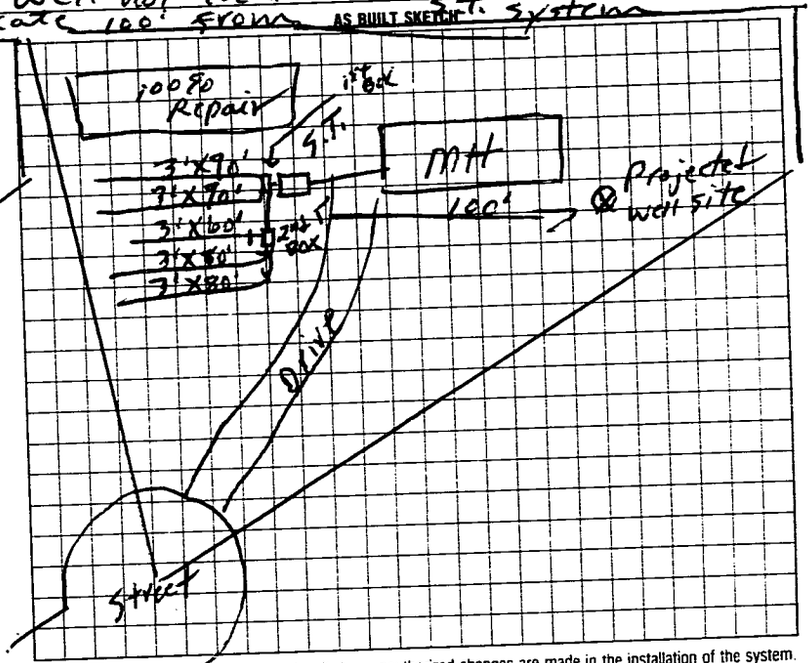

I understand that this permit can be suspended or revoked if any false information is supplied toward securing the permit/any unauthorized changes are made to the site/any unauthorized changes are made in the installation of the system. Improvement Permit is valid for 60 months from date of issuance.

Signed: x [signature] ____

Improvement Permit by: R.C. Moore date 6-14-93

Existing System Inspection by: ____ date ____

Installed by: A-1 Backhoe

Certificate of Completion by: R.C. Moore date 7-22-93

Operation Permit by: ____ date ____

HEALTH DEPT. COPY: WHITE INSPECTION COPY (FINAL): GREEN OWNER COPY (FINAL): YELLOW INSPECTION COPY (INITIAL): PINK OWNER COPY (INITIAL): GOLD