IREDELL COUNTY HEALTH DEPARTMENT

STATESVILLE 704-878-5305 ✓ MOORESVILLE 704-664-5281

IMPROVEMENT PERMIT / AUTHORIZATION TO CONSTRUCT / OPERATION PERMIT / EXISTING SYSTEM INSPECTION

PERMIT# 100170 PIN# 4761390831 DATE 5/9/01

OWNER OR CONTRACTOR Angela McKee PHONE: Business — Home (704) 528-5169

ADDRESS 136 Glass Rd. Statesville N.C. 28677

LOCATION Hwy 21 E, (R) Bethesda, (R) Gilespie, 5th on Left

SUBDIVISION — BLOCK / SECTION — LOT — LOT AREA .39 SITE CLASS 35 DESIGN FLOW 360 L.T.A.R. .3

Septic Tank: 1,000 Existing Gallons: STB — Date —
Pump Tank: — Gallons: PT — Date —
Pump Make: — Model — Serial No —
Nitrification Field: No Fields 1 Square Feet 40 Linear Feet 75 ft
No Lines 4 Existing Trench Width 36" Max Trench Bottom Depth 36" Gravel Depth —

☐ New System ☐ Repair System Type: I II III IV V VI
System Description: Gravity, Conv. 125% Reduction
Repair System Description: —
Maintenance Agreement Required: ☐ Yes ☐ No


☐ House/Mod Home ☒ Mobile Home ☐ Business ☐ Other
No. Bedrooms 3 No. Bathrooms 2 No. Employees —
☐ Slab ☒ Crawl Space ☐ Basement w/plumbing ☐ Basement wo/plumbing

Water Supply: ☒ Individual ☐ Public ☐ Community
Neighbors well


Comments/Conditions: ① Keep New line 10 ft off property liner ② Add one (1) 75' line of HOES or Chambers connect to dist. box ③ Replace distribution box if necessary

Comments/Conditions: ① Keep New Home 5ft From Septic System ② Added 100' of Corrugated pipe with 12" of Stone

INITIAL SITE SKETCH 107 ft Not to Scale

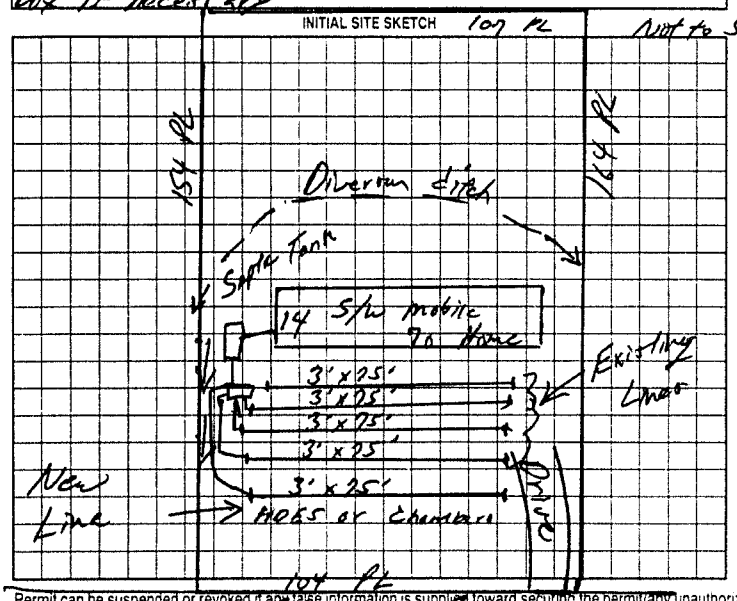

AS BUILT SKETCH 107' ft

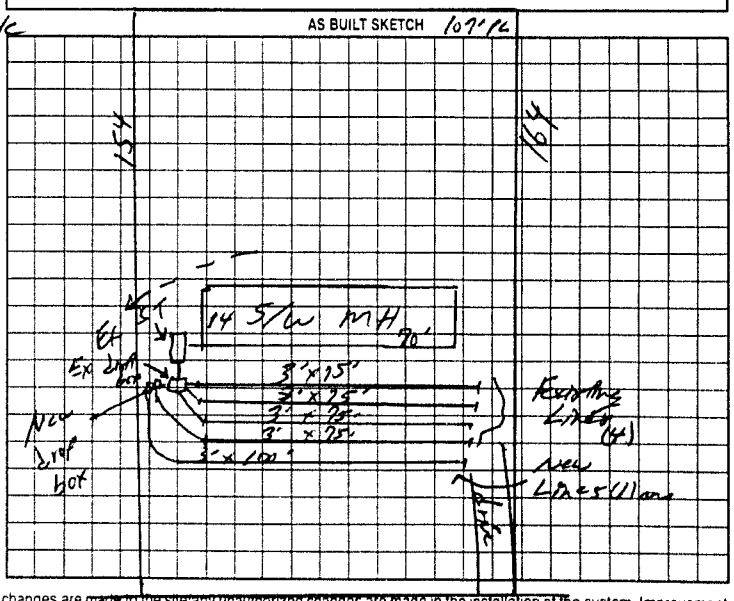

Permit can be suspended or revoked if any false information is supplied toward securing the permit/any unauthorized changes are made to the site/any unauthorized changes are made in the installation of the system. Improvement Permit with plat valid without expiration. Improvement Permit with site plan valid for sixty months. Authorization to Construct is valid for a period equal to that of Improvement Permit, not to exceed sixty months.

Signed: Billy McKee date 5/9-01 Installed by: Clyde Young

Improvement Permit by: William O. Johnson RSI date 5-9-01 Operation Permit by: William O. Johnson date 4/4/02

Authorization to Construct by: William O. Johnson RSI date 5-9-01 Existing System Inspection by: — date —

HEALTH DEPT COPY WHITE OWNER COPY (FINAL) YELLOW OWNER COPY (INITIAL) PINK