K.C.(R) Mtn. Coop Johnny Craven 663-2220

IREDELL COUNTY HEALTH DEPARTMENT

STATESVILLE 704-878-5305 MOORESVILLE 704-664-5281

IMPROVEMENT PERMIT / CERTIFICATE OF COMPLETION / OPERATION PERMIT / EXISTING SYSTEM INSPECTION

PROPERTY DESCRIPTION NO 20094 DATE 2-29-96 TAX MAP NO 5B-3-A-18

OWNER OR CONTRACTOR Scott Beattie PHONE Business 528-9913 Home Watershed: Yes ✓No

ADDRESS Rt 1 Box 259B

LOCATION Moe TR Trotman Chapel TR Reuben Dr. to Jeremy 5th lot left

SUBDIVISION Beechwood BLOCK / SECTION B LOT 18 LOT AREA 1.89 acres SITE CLASS P.S DESIGN FLOW 360 L.T.A.R 1.3

Septic Tank 1000 Gallons; STB 824 Date 7-31-97

Pump Tank: Gallons; PT Date

Pump Make: Model Serial No

Nitrification Field: No Fields 1 Square Feet 900 Linear Feet 300

No Lines 3 Trench Width 36" Max Trench Bottom Depth 36" Gravel Depth N/A

✓New System Repair System Type I II III IV V VI

System Description: Gravity chambers

Repair System Description: 11 panels

Maintenance Agreement Required Yes ✓No

House/Mod. Home No Bedrooms 3

✓Mobile Home No Bathrooms 2

Business No Employees

Other


Slab Crawl Space Basement w/plumbing Basement wo/plumbing

Water Supply ✓Individual Community Public


Comments: Run Chambers on contour of slope

Comments: *Note installer used Dist Boxes instead of running into tap

INITIAL SITE SKETCH

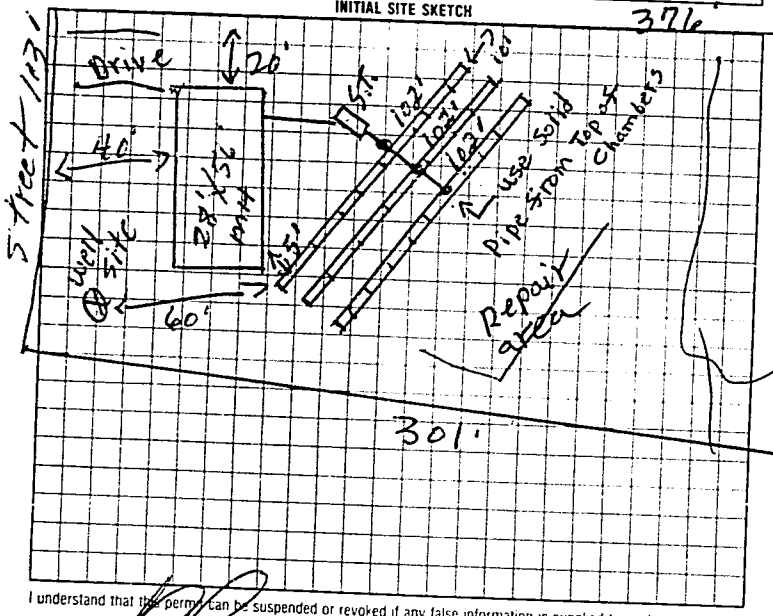

AS BUILT SKETCH

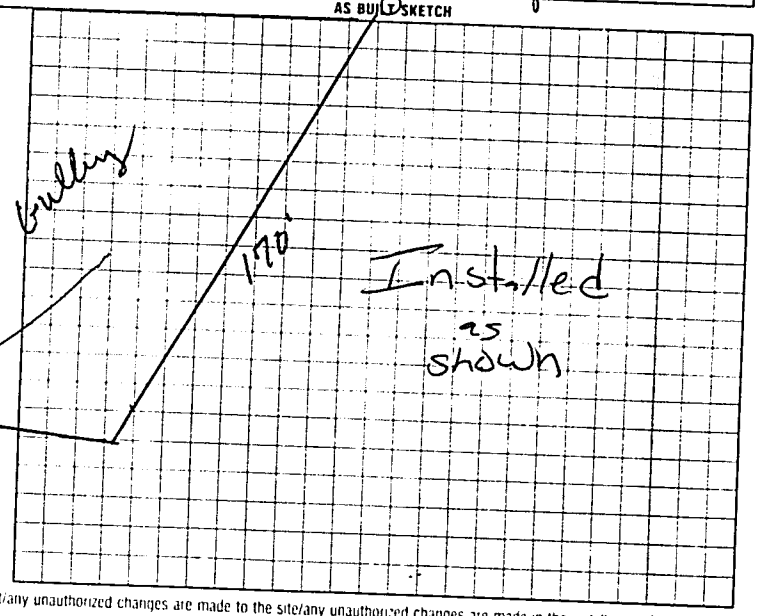

I understand that this permit can be suspended or revoked if any false information is supplied toward securing the permit/any unauthorized changes are made to the site/any unauthorized changes are made in the installation of the system

Signed

Improvement Permit by L.C. moore date 2-29-96

Authorization to Const. Existing System Inspection by L.C. moore date 2-29-96

Installed by G & M Enterprises

Certificate of Completion by date

Operation Permit by Mark Ott RS date 9-2-97

HEALTH DEPT COPY WHITE INSPECTION COPY (FINAL) GREEN OWNER COPY (FINAL) YELLOW INSPECTION COPY (INITIAL) PINK

Authorization to Const. Expires 60 months from issue