IREDELL COUNTY HEALTH DEPARTMENT

STATESVILLE 704-878-5305 MOORESVILLE 704-664-5281

61856 12:30

IMPROVEMENT PERMIT / CERTIFICATE OF COMPLETION / OPERATION PERMIT / EXISTING SYSTEM INSPECTION

PROPERTY DESCRIPTION NO. 30093 DATE 2-29-96 TAX MAP NO. 5B-3-A-17 Watershed: ☐ Yes ☐ No

OWNER OR CONTRACTOR Scott Beattie PHONE: Business 528-9913 Home

ADDRESS Rt 1 Box 340 Troutman

LOCATION 70E TR Bethesda TR Reuben Dr. TL Jeremy Ln. 2nd lot left

SUBDIVISION Beechwood BLOCK / SECTION II LOT 17 LOT AREA .8 acres SITE CLASS P5 DESIGN FLOW 240 L.T.A.R. .3

Septic Tank: 1000 Gallons: STB 821 Date 9-9-96
Pump Tank: Gallons: PT Date
Pump Make: Model Serial No
Nitrification Field: No Fields 1 Square Feet 600 Linear Feet 200
No Lines 2 Trench Width 36 Max Trench Bottom Depth 36 Gravel Depth N/A

☐ New System ☐ Repair System Type: I II (III) IV V VI
System Description: Gravity chambers
Repair System Description Gravity PPBPS
Maintenance Agreement Required: Yes ☒ No


☒ House/Mod. Home ☐ Mobile Home ☐ Business ☐ Other
No Bedrooms 2 No. Bathrooms 2 No Employees
☐ Slab ☐ Crawl Space ☐ Basement w/plumbing ☐ Basement wo/plumbing

Water Supply: ☒ Individual ☐ Community ☐ Public


Comments: MH is To be Set 150' off Road
Divert Surface water from Property line

Comments: Amended lay-out 10-17-96
To 3 lines of 72' Jcm
mobile Home & well Not on Site at Time of This inspection

INITIAL SITE SKETCH

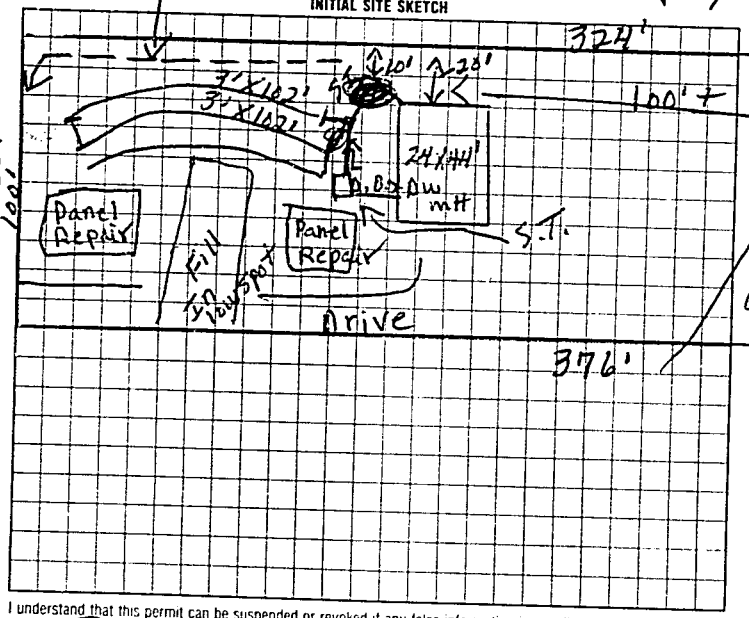

AS BUILT SKETCH

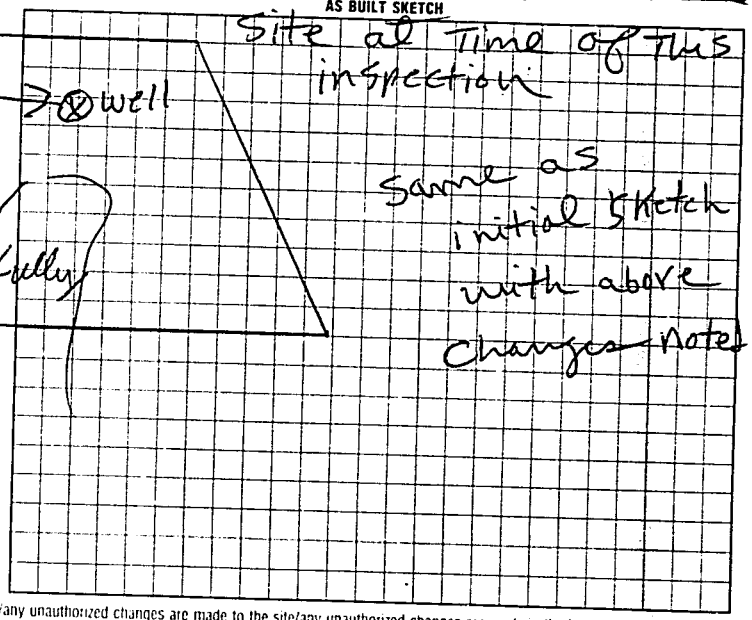

I understand that this permit can be suspended or revoked if any false information is supplied toward securing the permit/any unauthorized changes are made to the site/any unauthorized changes are made in the installation of the system.

Signed: Rochelle J. Harris

Improvement Permit by: F.C. moore date 2-29-96

Authorization for Installation Inspection by: F.C. moore date 2-29-96

Authorization to Const.

Installed by G&M Enterprizes

Certificate of Completion by: date

Operation Permit by: F.C. moore date 10-14-96

HEALTH DEPT. COPY WHITE INSPECTION COPY (FINAL) GREEN OWNER COPY (FINAL) YELLOW INSPECTION COPY (INITIAL) PINK OWNER COPY (INITIAL) GOLD

Authorization to Const Expires 6 months from issue