THIS PERMIT VOIDS PREVIOUS ISSUED 2-21-2000

IREDELL COUNTY HEALTH DEPARTMENT

STATESVILLE 704-878-5305 MOORESVILLE 704-664-5281

IMPROVEMENT PERMIT / AUTHORIZATION TO CONSTRUCT / OPERATION PERMIT / EXISTING SYSTEM INSPECTION

PERMIT# 87833 PIN# 4761 39 2799 DATE 1-16-2001

OWNER OR CONTRACTOR BETTY JEAN ALLISON PHONE: Business Home (919) 669-8090

ADDRESS P.O. BOX 7616 STATESVILLE NC 28687

LOCATION US 70 E, TR BETHESDA RD, TR GLASPY ROAD, 3RD LOT ON LEFT

SUBDIVISION BLOCK / SECTION LOT LOT AREA 0.46 ACRES SITE CLASS PS DESIGN FLOW 360 L.T.A.R. 0.30 gpd/ft²

Septic Tank: 1000 Gallons: STB 825 Date 2-11-01

Pump Tank: 1000 Gallons, PT 302 Date 1-21-01

Pump Make: GOULDS Model WE0311M Serial No B0144378

Nitrification Field: No Fields 1 Square Feet EQ I= 1200 Linear Feet 200

No Lines FIVE Trench Width 24" Max Trench Bottom Depth 36" Gravel Depth SAND 6"

☑ New System ☐ Repair System Type: I. II (III) IV. V. VI

System Description: 50% REDUCTION, PUMP

Repair System Description: MAX. FEASIBLE

Maintenance Agreement Required: ☐ Yes ☑ No

☐ House/Mod. Home ☑ Mobile Home ☐ Business ☐ Other

No. Bedrooms 3 No. Bathrooms 2 No. Employees


☐ Slab ☑ Crawl Space ☐ Basement w/plumbing ☐ Basement wo/plumbing

Water Supply: ☑ Individual ☐ Public ☐ Community WELL

Comments/Conditions: ① INSTALL FIFTY (50) PPBPS PANELS IN FIVE (5) EQUAL LENGTH LINES ON CONTOUR AS FLAGGED ② SEE ATTACHED SHEETS FOR PUMP AND PRESSURE MANIFOLD REQUIREMENTS

Comments/Conditions: SYSTEM INSTALLED WITH ACV COIL FILTER, PRESSURE CHECKED 3-28-01

INITIAL SITE SKETCH SCALE: 1" = 40'

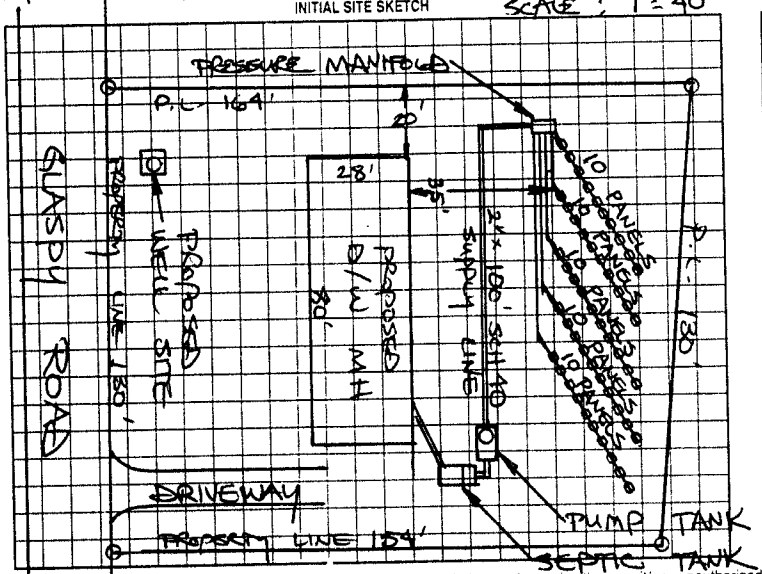

AS BUILT SKETCH

Permit can be suspended or revoked if any false information is supplied toward securing the permit/any unauthorized changes are made to the site/any unauthorized changes are made in the installation of the system. Improvement Permit with plat valid without expiration. Improvement Permit with site plan valid for sixty months. Authorization to Construct is valid for a period equal to that of Improvement Permit – not to exceed sixty months.

Signed: Betty J. Allison date 1-16-01

Improvement Permit by: STEVE HEDRICK date 1-16-2001

Authorization to Construct by: STEVE HEDRICK date 1-16-2001

Installed by: UPRIGHT GRADING

Operation Permit by: Jimmy Shinn date 4/12/01

Existing System Inspection by: date

HEALTH DEPT. COPY: WHITE OWNER COPY (FINAL): YELLOW OWNER COPY (INITIAL): PINK