11:30

IREDELL COUNTY HEALTH DEPARTMENT

STATESVILLE 704-878-5305 MOORESVILLE 704-664-5281

IMPROVEMENT PERMIT / CERTIFICATE OF COMPLETION / OPERATION PERMIT / EXISTING SYSTEM INSPECTION

PROPERTY DESCRIPTION NO. 06946 DATE 9-8-97 TAX MAP NO. 4761394241 Watershed: ☐ Yes ☒ No

OWNER OR CONTRACTOR Patsy Hayes PHONE: Business _____ Home 528-6092

ADDRESS 932 Bethesda Rd Statesville

LOCATION Bethesda Rd After Reuben on (L) 2nd Driveway

SUBDIVISION _____ BLOCK / SECTION _____ LOT _____ LOT AREA 20,000 SITE CLASS. P/S DESIGN FLOW 480 L.T.A.R. 0.35

Septic Tank: 1000 Gallons; STB 1012 Date 6-30-97

Pump Tank: _____ Gallons; PT _____ Date _____

Pump Make: _____ Model _____ Serial No. _____

Nitrification Field: No Fields 1 Square Feet 1371 Linear Feet 457

No Lines 6 Trench Width 36in Max Trench Bottom Depth 36in Gravel Depth 12in

☒ New System ☐ Repair System Type: I, II, III, IV, V, VI

System Description: Conventional/Gravity

Repair System Description: _____

Maintenance Agreement Required: ☒ Yes ☐ No

☐ Slab ☒ Crawl Space ☐ Basement w/plumbing ☐ Basement wo/plumbing

☐ House/Mod. Home ☒ Mobile Home ☐ Business ☐ Other


No. Bedrooms 3 No. Bathrooms 2 No. Employees _____

Water Supply: ☒ Individual ☐ Community ☐ Public


Comments: Keep lines on contour 3ft on center
Keep water line 10ft from system

Comments:

INITIAL SITE SKETCH Bethesda Rd

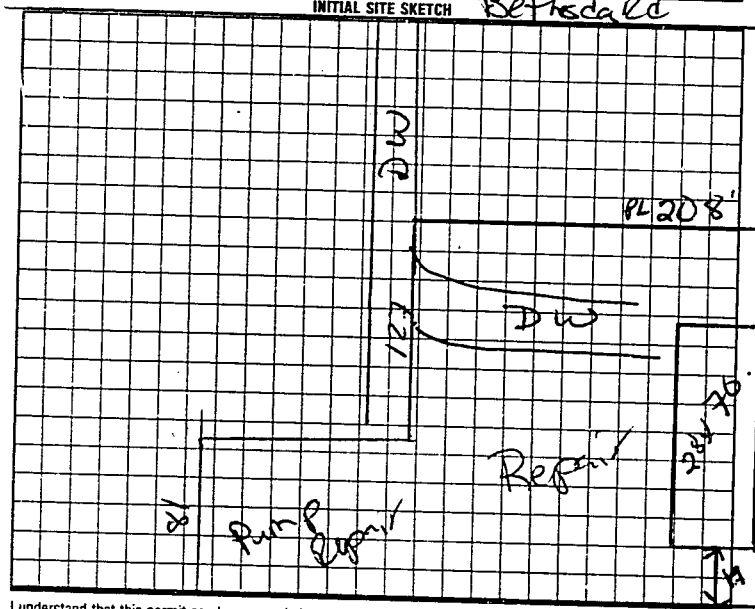

AS BUILT SKETCH

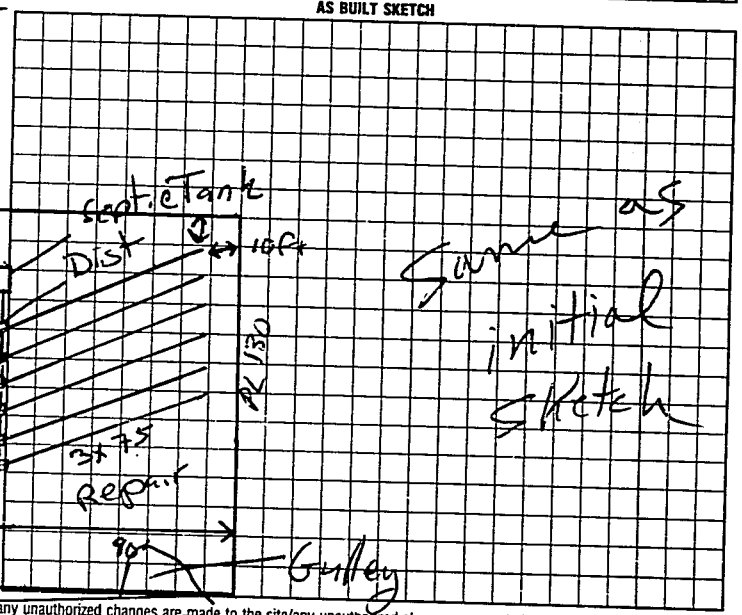

I understand that this permit can be suspended or revoked if any false information is supplied toward securing the permit/any unauthorized changes are made to the site/any unauthorized changes are made in the installation of the system. Improvement Permit is valid for 60 months from date of issuance.

Signed: _____

Improvement Permit by: Authorization to Const. Mark C Ott RS date 9-8-97

Existing System Inspection by: Mark C Ott RS date 9-8-97

Installed by: A-1 Backhoe

Certificate of Completion by: _____ date _____

Operation Permit by: W. C. Moore date 9-12-97

HEALTH DEPT. COPY: WHITE INSPECTION COPY (FINAL): GREEN OWNER COPY (FINAL): YELLOW INSPECTION COPY (INITIAL): PINK OWNER COPY (INITIAL): GOLD