IREDELL COUNTY HEALTH DEPARTMENT

STATESVILLE 704-878-5305 — MOORESVILLE 704-664-5281

52132 — 3:00 Thursday

IMPROVEMENT PERMIT / CERTIFICATE OF COMPLETION / OPERATION PERMIT / EXISTING SYSTEM INSPECTION

PROPERTY DESCRIPTION NO. 1915/0 — DATE 7-13-94 — TAX MAP NO. 5B-A-17 — Watershed: ☐ Yes ☑ No

OWNER OR CONTRACTOR Rufus Hegsgeans — PHONE: Business _____ Home 528-9816

ADDRESS 105 Glasgow Rd

LOCATION 70E TR Bethesda Rd TR Glasgow 1st mail out left

SUBDIVISION _____ BLOCK / SECTION _____ LOT _____ LOT AREA 154 x 350 SITE CLASS. P3 DESIGN FLOW 360 L.T.A.R. .3

Septic Tank: 1000 Gallons; STB ~~1-17-95~~ Date 1-17-95

Pump Tank: _____ Gallons; PT 1012 Date _____

Pump Make: _____ Model _____ Serial No. _____

Nitrification Field: No Fields ___ Square Feet _____ Linear Feet _____

No Lines _____ Trench Width _____ Max Trench Bottom Depth _____ Gravel Depth _____

☑ New System ☐ Repair System Type: I, II, III, IV, V, VI

System Description: conv. trench

Repair System Description: " "

Maintenance Agreement Required: ☐ Yes ☑ No

☐ House/Mod. Home ☑ Mobile Home ☐ Business ☐ Other

No. Bedrooms 3 — No. Bathrooms 2 — No. Employees ___


☐ Slab ☐ Crawl Space ☐ Basement w/plumbing ☐ Basement wo/plumbing

Water Supply: ☑ Individual ☐ Community ☐ Public

Comments:

Bethesda Rd

INITIAL SITE SKETCH

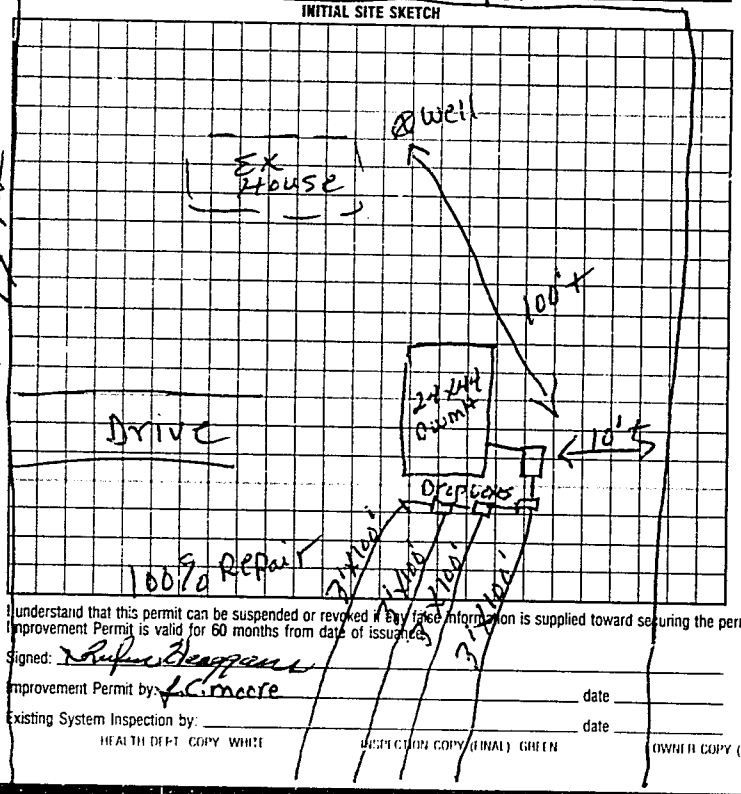

Comments:

AS BUILT SKETCH

Same as initial sketch

I understand that this permit can be suspended or revoked if any false information is supplied toward securing the permit/any unauthorized changes are made to the site/any unauthorized changes are made in the installation of the system. Improvement Permit is valid for 60 months from date of issuance.

Signed: Rufus Hegsgeans

Improvement Permit by: L.C. Moore date _____

Existing System Inspection by: _____ date _____

Installed by: Clyde Young

Certificate of Completion by: L.C. Moore date 4-20-95

Operation Permit by: _____ date _____

HEALTH DEPT COPY: WHITE — INSPECTION COPY (FINAL): GREEN — OWNER COPY (FINAL): YELLOW — INSPECTION COPY (INITIAL): PINK — OWNER COPY (INITIAL): GOLD

21900