IREDELL COUNTY HEALTH DEPARTMENT

Statesville Office (704) 878-5305 | Mooresville Office (704) 660-3625 | PERMIT # 218635

IMPROVEMENT PERMIT / AUTHORIZATION TO CONSTRUCT / OPERATION PERMIT / EXISTING SYSTEM

PIN # 4761-40-5292

APPLICANT: Kimberly Sneed | APPLICANT ADDRESS: 1124 Charlotte Highway, Troutman, NC

SITE ADDRESS: 105 Fairhaven Lane Cleveland, NC | PHONE: 704-528-7960 | ALT. PHONE:

SITE DIRECTIONS: N on Rt 21 from Mooresville → R on Shinnville Rd → Left on Brawley Rd → R on Fairhaven → 1st lot on left (corner)


SUBDIVISION: Fairhaven | SECTION: 1 | LOT # 1 | LOT AREA: 0.60 acres | DESIGN FLOW: 360 GPD | L.T.A.R.: 0.30

Septic Tank	1000 (gal)	STB	1012	Date	3/24/16	☒ New System	☐ Repair	☐ Expansion	System Type: I II (III) IV V VI	☒ Residence	No. Bedrooms 3
Pump Tank	— (gal)	PT	—	Date	—	System Description:			25% Reduction (Serial distribution)	☐ Business	No. Persons 6
Pump Make	—	Model	—	Serial #	312	Repair System Description:			LP-PPBPS (50% Reduction)	☐ Other	No. Employees —
# Nitrification Fields	1	# Lines	5	Linear Ft:	~~300~~	Maintenance Agreement Required:	☐ YES	☒ NO		☐ Slab	☒ Crawl Space
Trench Width	36"	Max. Trench Bottom Depth	33" (Low side)	Gravel Depth	—		☒ GRAVITY	☐ PRESSURE		☐ Basement w/plumbing	☐ Basement w/o plumbing

Water Supply: ☒ Private ☐ Public ☐ Community

Comments / Conditions: Follow all N.C. septic rules. Remove rubble/rip-rap pile where indicated. Recommend pumping septic every 3-5 years.

INITIAL SITE SKETCH

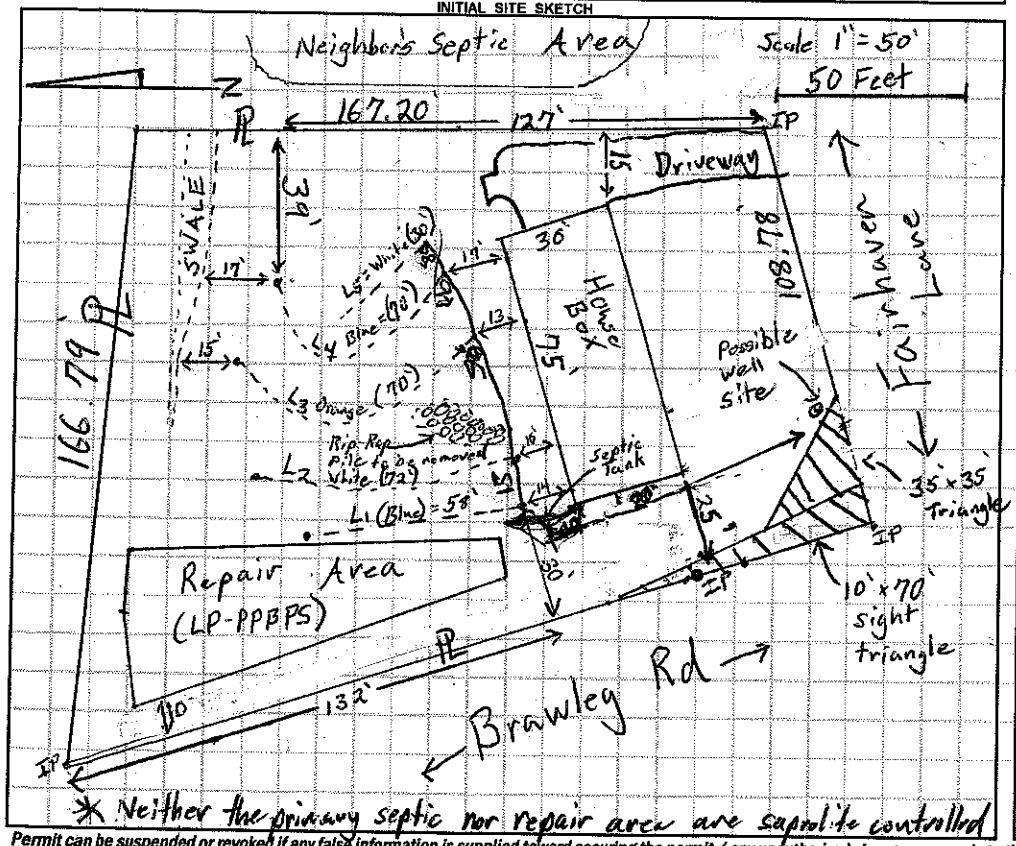

AS BUILT SKETCH

Permit can be suspended or revoked if any false information is supplied toward securing the permit / any unauthorized changes are made to the site / any unauthorized changes are made in the installation of the system. **CONTACT A LOCATOR SERVICE PRIOR TO ANY EXCAVATION**

☐ **IMPROVEMENT PERMIT** *with plat valid without expiration.* ☒ **IMPROVEMENT PERMIT** *with site plan valid for 60 mos.* ☒ **AUTHORIZATION TO CONSTRUCT** *valid for period equal to IMPROVEMENT PERMIT--not to exceed 60 mo.*

Owner / Applicant Signature: Kimberly Sneed | Date: 8-23-16 | Installed by: Craig Thompson

IMPROVEMENT PERMIT by: Tom Shuck | Date: 8-17-16 | OPERATION PERMIT by: [signature] | Date: 10/28/16

AUTHORIZATION TO CONSTRUCT by: Tom Shuck | Date: 8-17-16 | Existing System Inspected by: | Date:

Health Dept. Copy - WHITE Applicant (Final Approval) - YELLOW Applicant (Conditional Approval) - PINK