11:00

IREDELL COUNTY HEALTH DEPARTMENT

STATESVILLE 704-878-5305 MOORESVILLE 704-664-5281

IMPROVEMENT PERMIT / AUTHORIZATION TO CONSTRUCT / OPERATION PERMIT / EXISTING SYSTEM INSPECTION

PERMIT# 134410 PIN# 4761407250 DATE 6-27-06

OWNER OR APPLICANT Greg Cairns PHONE: Business 746-6211 Home

ADDRESS P.O. Box 1082 Mooresville, NC. 28115 111 FAIRHAVEN

LOCATION US 21 North TR Shinnville Rd TL Brawley Rd TR Fairhaven 2nd on left

SUBDIVISION Fairhaven BLOCK / SECTION LOT 2 LOT AREA .65 Acre SITE CLASS. PS DESIGN FLOW 360gpd L.T.A.R. .3 to .35

Septic Tank: 1000 Gallons: STB 760 Date 4-2-08
Pump Tank: 1000 Gallons: PT 363 Date 5-30-08
Pump Make: Zoeller Model BN 152 Serial No.
Nitrification Field: No Fields 1 Square Feet 900' Linear Feet 300'
No Lines 3@100' Trench Width 36" Max Trench Bottom Depth 36" Gravel Depth N/A ☐ Gravity ☒ Pressure ☐ Slab ☒ Crawl Space ☐ Basement w/plumbing ☐ Basement wo/plumbing

☒ New System ☐ Repair ☐ Expansion System Type: I II III IV V VI
System Description: Pump-25% Reduction
Repair System Description: Pump-LP-Panel Blk
Maintenance Agreement Required: ☐ Yes ☒ No


☒ House/Mod. Home No. Bedrooms 3
☐ Mobile Home No. Persons
☐ Business No. Employees
☐ Other

Water Supply: ☒ Individual ☐ Public ☐ Community

Comments:/Conditions:

Keep Septic System at least 10ft to PL & 50ft from any well.
Build up if needed for House pad, Do Not Cut for House pad.

INITIAL SITE SKETCH

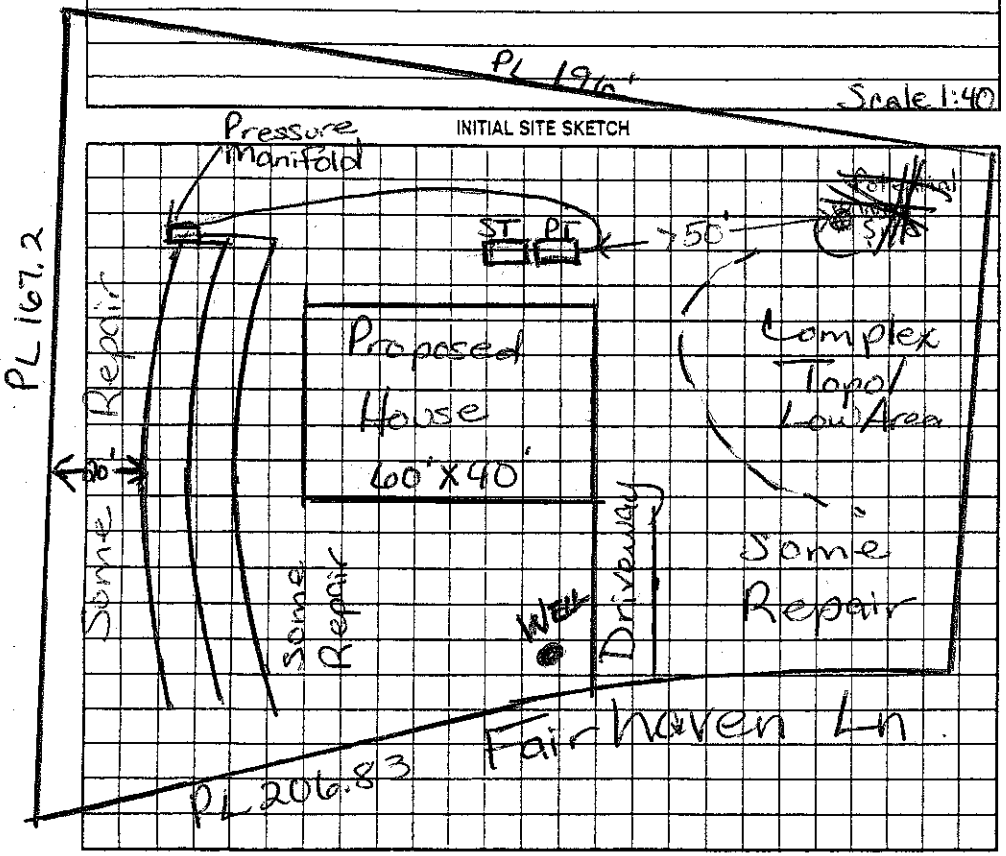

AS BUILT SKETCH

Red Filter installed in ST 8/12/08 Checked tanks, lines & pressure

Permit can be suspended or revoked if any false information is supplied toward securing the permit/any unauthorized changes are made to the site/any unauthorized changes are made in the installation of the system. Improvement Permit with plat valid without expiration ☐ Improvement Permit with site plan valid for sixty months ☐ Authorization to Construct is valid for a period equal to that of Improvement Permit – not to exceed sixty months.

Signed: Gregory Cairns date 7/12/06 Installed by: Abee's Grading

Improvement Permit by: Myra H. Dotson RS date 6/27/06 Operation Permit by: Wesley Sparks RS. date 2/3/09

Authorization to Construct by: Myra H. Dotson RS date 6/27/06 Existing System Inspection by: date

HEALTH DEPT. COPY: WHITE OWNER COPY (FINAL): YELLOW OWNER COPY (INITIAL): PINK