IREDELL COUNTY HEALTH DEPARTMENT

STATESVILLE 704-878-5305 MOORESVILLE 704-664-5281

(1:30) - A-1 Backhoe

IMPROVEMENT PERMIT / AUTHORIZATION TO CONSTRUCT / OPERATION PERMIT / EXISTING SYSTEM INSPECTION

PERMIT# 082692 PIN# ~~4761-63-1580 (pt)~~ 4761-42-2637 DATE Jan. 24 2000

OWNER OR CONTRACTOR Deer Valley Dev. Group LLC PHONE: Business 664-9080 Home

ADDRESS 235 Rolling Hills Rd. Mooresville

LOCATION 115-21 N. TR 1001 (Ostwalt-Amity) TR Brawley Rd. TR Ave Meadow Ct. at end on left

SUBDIVISION Deer Valley BLOCK / SECTION 2 LOT 5 LOT AREA 1.685 Ac SITE CLASS. PS DESIGN FLOW 360gpd L.T.A.R. .03

Septic Tank: 1000 Gallons; STB 1012 Date 4/7/01

Pump Tank: Gallons; PT Date

Pump Make: Model Serial No.

Nitrification Field: No Fields 1 Square Feet 900 Linear Feet 300

No Lines 3 @ 100' Trench Width 36" Max Trench Bottom Depth 36" Gravel Depth N/A

☑ New System ☐ Repair System Type: I, II, III, IV, V, VI

System Description: Gravity Innovative-25% Red

Repair System Description: Gravity pumped Innovative

Maintenance Agreement Required? ☐ Yes ☑ No

☑ House/Mod. Home No. Bedrooms 3

☐ Mobile Home No. Bathrooms 2

☐ Business No. Employees

☐ Other

☐ Slab ☑ Crawl Space ☐ Basement w/plumbing ☐ Basement wo/plumbing


Water Supply: ☑ Individual ☐ Public ☐ Community

Comments:/Conditions: ⊛ ONE inspection port per lateral


Comments:/Conditions:

1" = 60'

INITIAL SITE SKETCH

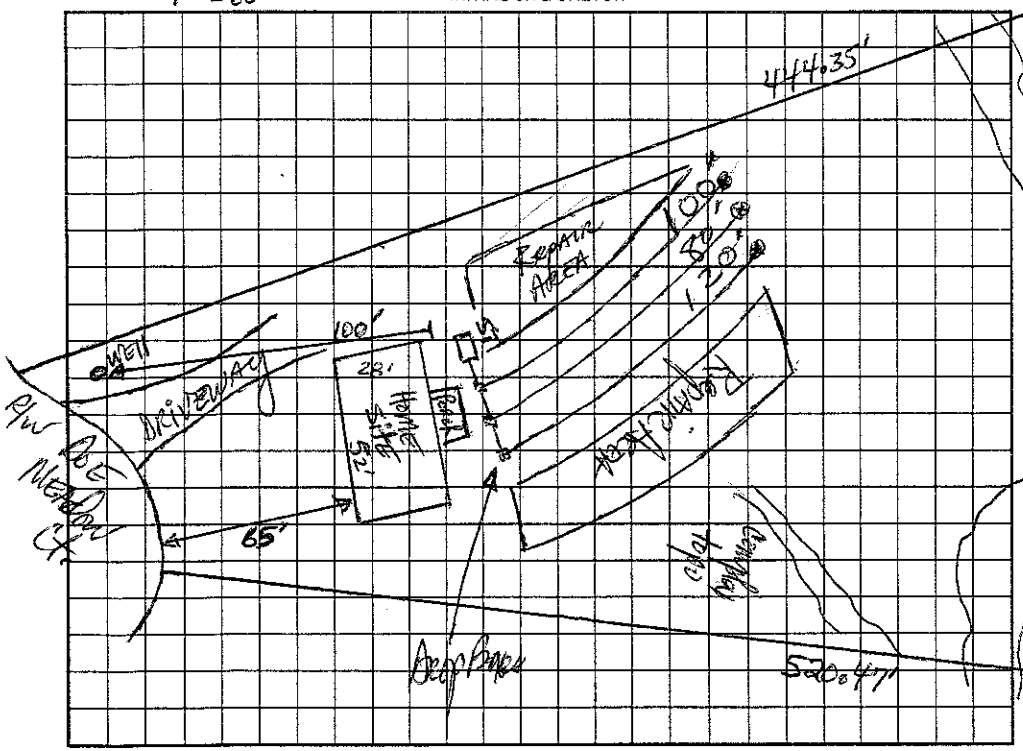

AS BUILT SKETCH

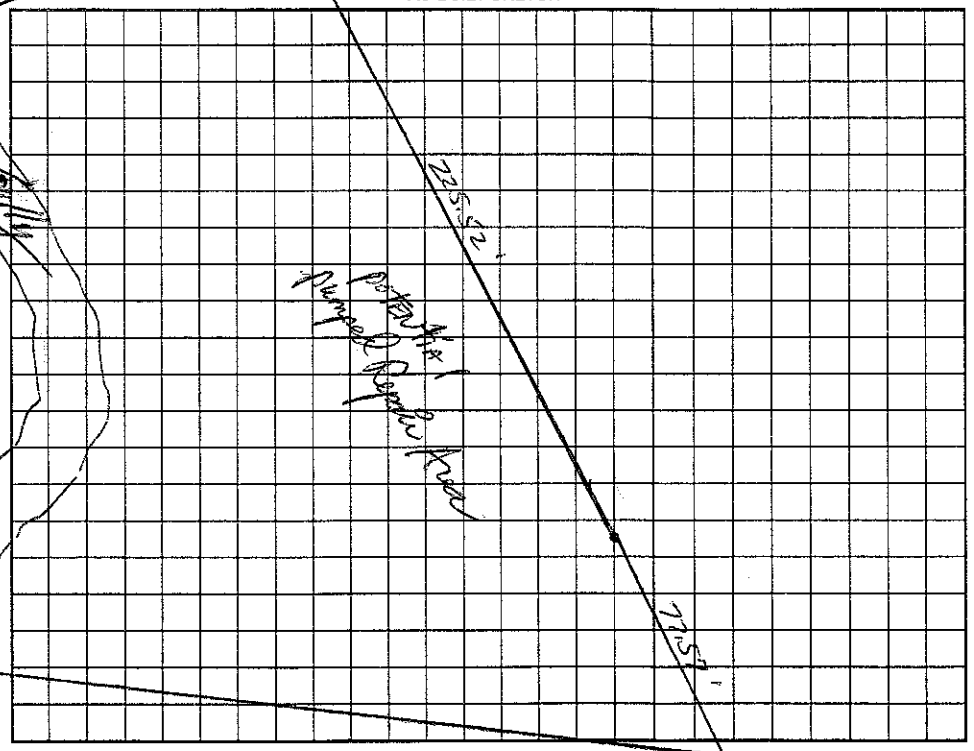

Permit can be suspended or revoked if any false information is supplied toward securing the permit/any unauthorized changes are made to the site/any unauthorized changes are made in the installation of the system. Improvement Permit with plat valid without expiration. Improvement Permit with site plan valid for sixty months. Authorization to Construct is valid for a period equal to that of Improvement Permit – not to exceed sixty months.

Signed: date 2/1/00 Installed by: A-1 Backhoe

Improvement Permit by: date 1-24-2000 Operation Permit by: RS date 4/5/02

Authorization to Construct by: date 1-24-2000 Existing System Inspection by: date

HEALTH DEPT. COPY: WHITE OWNER COPY (FINAL): YELLOW OWNER COPY (INITIAL): PINK