4761 42 3375

IREDELL COUNTY HEALTH DEPARTMENT

STATESVILLE 704-878-5305 MOORESVILLE 704-664-5281

IMPROVEMENT PERMIT / CERTIFICATE OF COMPLETION / OPERATION PERMIT / EXISTING SYSTEM INSPECTION

PROPERTY DESCRIPTION NO. 12595 DATE 9/9/93 TAX MAP NO. 5B-A-48

OWNER OR CONTRACTOR DALE TOLBERT PHONE: Business Home 872-8060

ADDRESS BRAWLEY RD. MOORESVILLE, NC.

LOCATION Brawley Rd, (L) off Shimmiville to last house on (L) before Oswalt Country Rd.

SUBDIVISION No! BLOCK / SECTION LOT No LOT AREA ACREAGE SITE CLASS. P L.T.A.R. .25-.3

Water Supply: ☑ Individual ☐ Community ☐ Public

Septic Tank: 1000 Gallons; STB 1012 Date 12/6/94

Pump Tank: Gallons; PT Date

Nitrification Field: No Fields 1 Square Feet ~~300+200~~ AWS Linear Feet ~~400~~ 270 AWS

No Lines 3 Trench Width 3' Trench Depth 30-32" Gravel Depth 12"

☑ New System ☐ Repair System Type: I (II), II, IV, V, VI

System Description: CONV.

Repair System Description: CONV.

Maintenance Agreement Required: ~~☐ Yes~~ ☐ No

☑ House/Mod. Home No. Bedrooms ~~3~~ 2 AWS Garbage Disposal: ☐ Yes ☑ No

☐ Mobile Home No. Bathrooms 2 Auto. Dishwasher: ☑ Yes ☐ No


☐ Business No. Employees Auto. Washing Machine: ☑ Yes ☐ No

☐ Other Other


☐ Slab ☐ Crawl Space ☑ Basement w/plumbing ☐ Basement wo/plumbing

Comments 50' from any well. Lines no deeper than 32" to trench bottom, Keep lines on slope contour in direction shown.
2/21/94 - Revised to 270 linear feet for 2 BDRM House - AWS.
3/29/94 - FAXED TO 531-9880

INITIAL SITE SKETCH

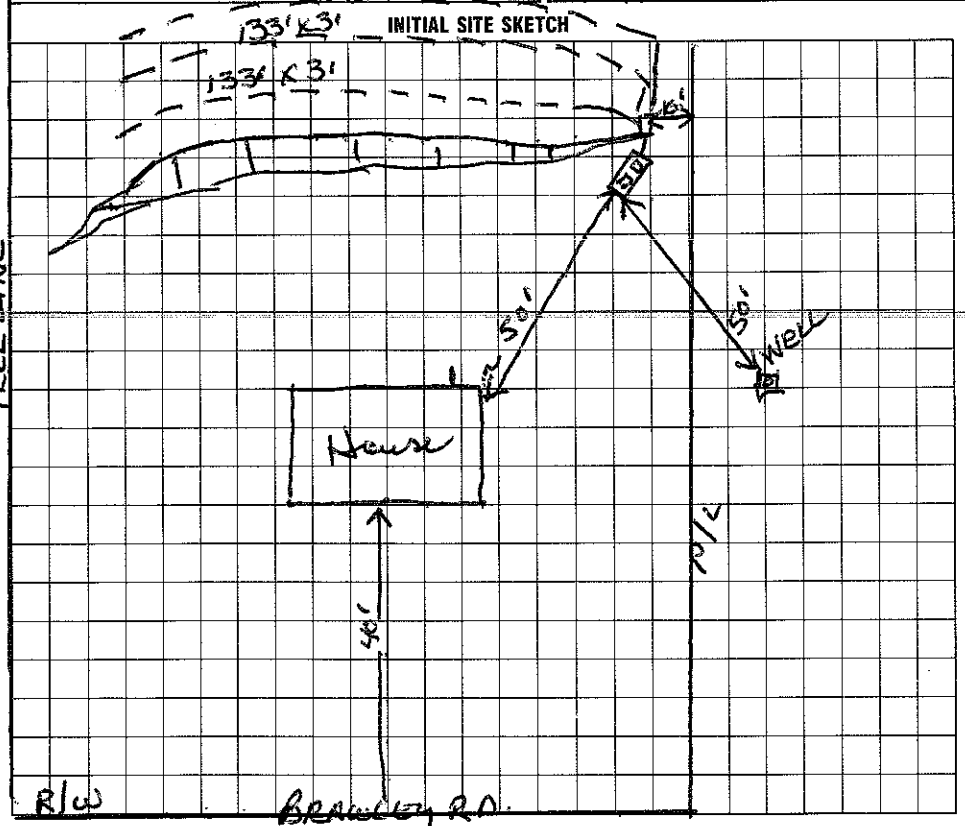

AS BUILT SKETCH

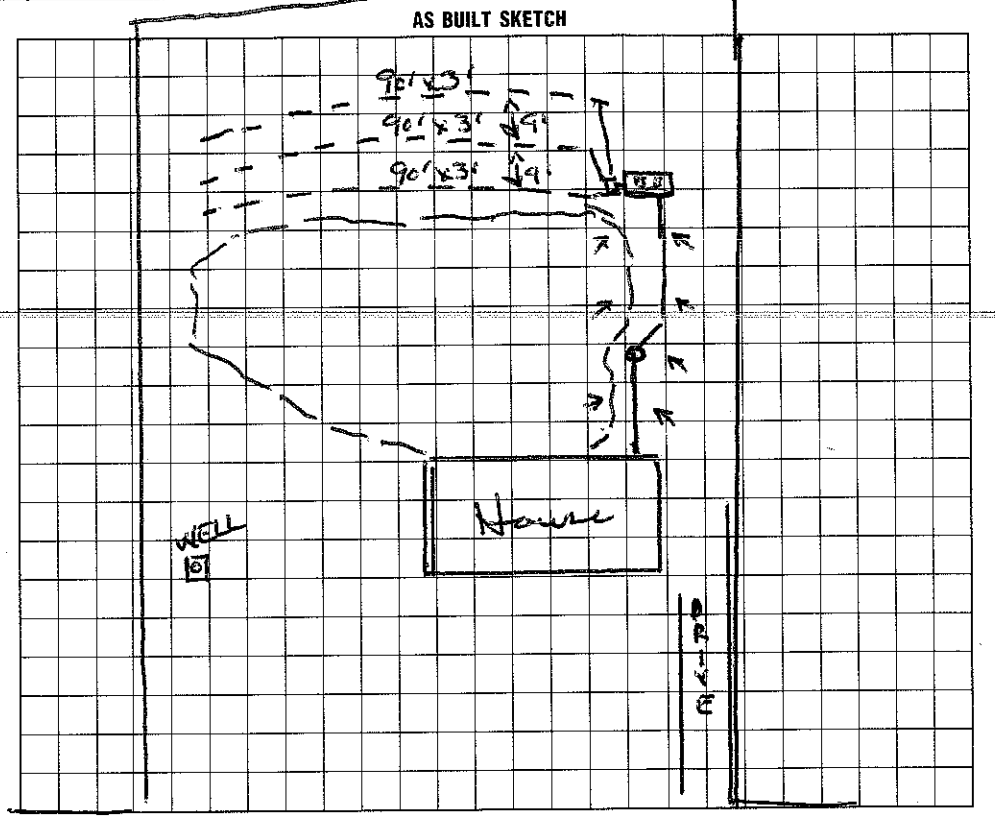

I understand that this permit can be suspended or revoked if any false information is supplied toward securing the permit/any unauthorized changes are made to the site/any unauthorized changes are made in the installation of the system. Improvement Permit is valid for 60 months from date of issuance.

Signed: Dale Tolbert

Improvement Permit by: Wesley Sparks R.S. date 9/9/93

Existing System Inspection by: date

Installed by: Harry Reep BRAWLEY RD.

Certificate of Completion by: Wesley Sparks R.S. date 3/23/94

Operation Permit by: date

HEALTH DEPT. COPY: WHITE INSPECTION COPY (FINAL): GREEN OWNER COPY (FINAL): YELLOW INSPECTION COPY (INITIAL): PINK OWNER COPY (INITIAL): GOLD