(1:30)

IREDELL COUNTY HEALTH DEPARTMENT

STATESVILLE 704-878-5305 MOORESVILLE 704-664-5281

IMPROVEMENT PERMIT / AUTHORIZATION TO CONSTRUCT / OPERATION PERMIT / EXISTING SYSTEM INSPECTION

PERMIT# 082688 PIN# ~~4761 05 1580 (pt)~~ 4761-42-4545 DATE October 29, '99

OWNER OR CONTRACTOR Deer Valley LLC PHONE: Business 664-9080 Home

ADDRESS 255 Rolling Hills Rd. Mooresville

LOCATION 115-21 N. TR 1001 (Oswalt-Amity) TR Brawley Rd. on Right

SUBDIVISION Deer Valley BLOCK / SECTION LOT 1 LOT AREA 1.27Ac SITE CLASS. PS DESIGN FLOW 360gpd L.T.A.R. e3

Septic Tank: 1000 Gallons; STB 55 Date 11/4/99
Pump Tank: Gallons; PT Date
Pump Make: Model Serial No.
Nitrification Field: No Fields 1 Square Feet 1200 Linear Feet 400
No Lines 3@134' Trench Width 36" Max Trench Bottom Depth 36"

☑ New System ☐ Repair System Type: I, II, III, IV, V, VI
System Description: Gravity Conventional
Repair System Description: same
Maintenance Agreement Required: ☐ Yes ☑ No
Gravel Depth 12" ☐ Slab ☑ Crawl Space ☐ Basement w/plumbing ☐ Basement wo/plumbing

☑ House/Mod. Home No. Bedrooms 3
☐ Mobile Home No. Bathrooms 2
☐ Business No. Employees
☐ Other


Water Supply: ☐ Individual ☐ Public ☐ Community

Comments:/Conditions:

Comments:/Conditions:

1" = 50'

INITIAL SITE SKETCH

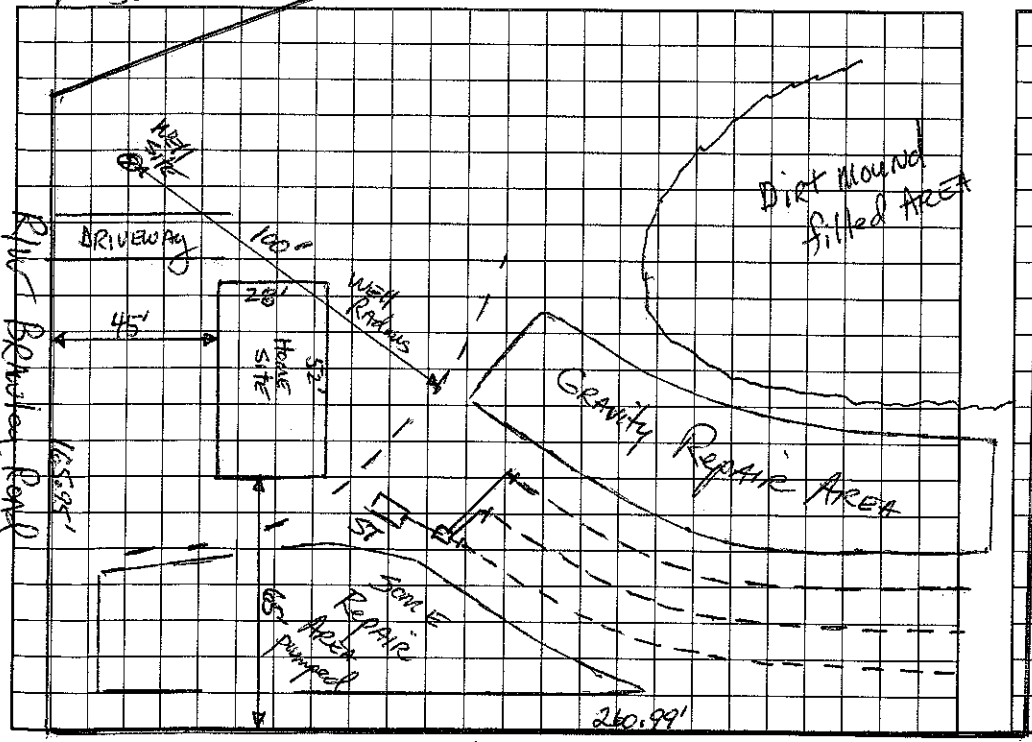

AS BUILT SKETCH

Permit can be suspended or revoked if any false information is supplied toward securing the permit/any unauthorized changes are made to the site/any unauthorized changes are made in the installation of the system. Improvement Permit with plat valid without expiration. Improvement Permit with site plan valid for sixty months. Authorization to Construct is valid for a period equal to that of Improvement Permit – not to exceed sixty months.

Signed: date

Improvement Permit by: RS date 10-29-99

Authorization to Construct by: RS date 10-29-99

Installed by: Larry Reap

Operation Permit by: Wesley Apodaca RS. date 3/15/00

Existing System Inspection by: date

HEALTH DEPT. COPY: WHITE OWNER COPY (FINAL): YELLOW OWNER COPY (INITIAL): PINK