IREDELL COUNTY HEALTH DEPARTMENT

STATESVILLE 704-878-5305 MOORESVILLE 704-664-5281

IMPROVEMENT PERMIT / AUTHORIZATION TO CONSTRUCT / OPERATION PERMIT / EXISTING SYSTEM INSPECTION

PERMIT# 082689 PIN# ~~4761-65-1580 (pt)~~ 4761-42-7710 DATE Dec 1, '99

OWNER OR CONTRACTOR Deer Valley Dev. Group LLC PHONE: Business _____ Home _____

ADDRESS 255 Rolling Hills Rd. Mooresville

LOCATION 21 N. TR Ostwalt-Amity Road TR Brawley Road on Right at jct w/ Doe Meadow Ct.

SUBDIVISION Deer Valley BLOCK / SECTION 1 LOT 2 LOT AREA .9AC SITE CLASS. PS DESIGN FLOW 360gpd L.T.A.R. .3

Septic Tank: 1000 Gallons; STB 1012 Date 11/8/99

Pump Tank: _____ Gallons; PT _____ Date _____

Pump Make: _____ Model _____ Serial No. _____

Nitrification Field: No Fields 1 Square Feet 1200 Linear Feet 400

No Lines 4@100' Trench Width 36" Max Trench Bottom Depth 36" Gravel Depth 12"

☑ New System ☐ Repair System Type: I, II, III, IV, V, VI

System Description: Gravity Conventional

Repair System Description: Same

Maintenance Agreement Required: ☐ Yes ☑ No

☑ House/Mod. Home No. Bedrooms 3

☐ Mobile Home No. Bathrooms 2

☐ Business No. Employees _____

☐ Other _____

☐ Slab ☑ Crawl Space ☐ Basement w/plumbing ☐ Basement wo/plumbing


Water Supply: ☑ Individual ☐ Public ☐ Community

Comments:/Conditions: 1-20-2000 OK to orient Home parallel to Doe Meadow Ct. 40'S/L Doe Meadow & one end-left side to be 50' off Brawley Rd R/W


Comments:/Conditions:

1" = 50'

INITIAL SITE SKETCH

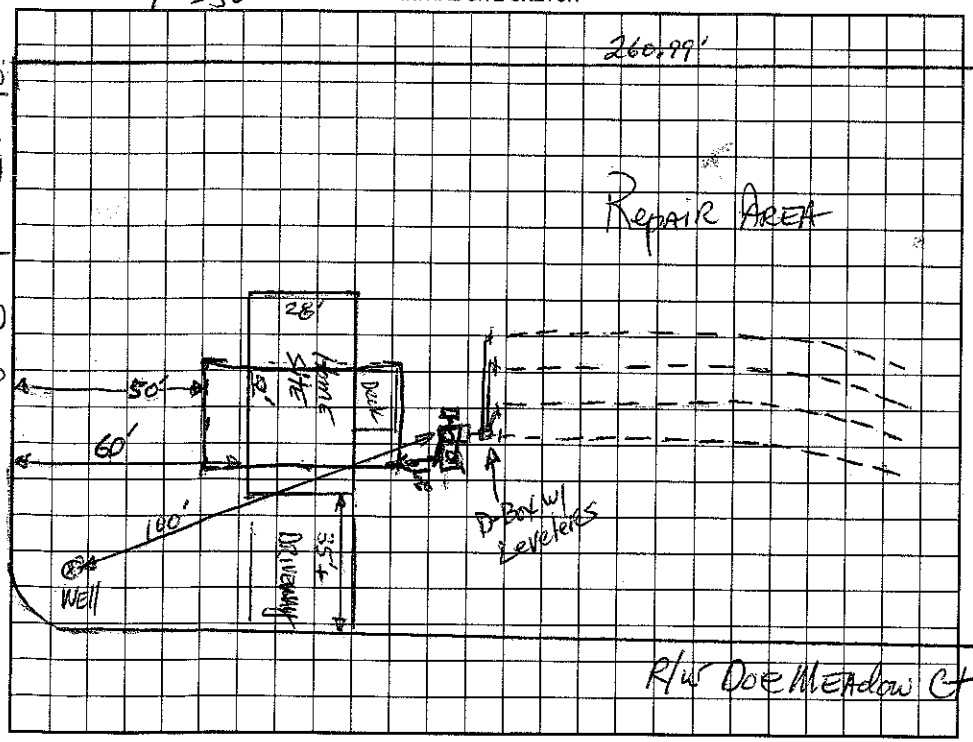

AS BUILT SKETCH

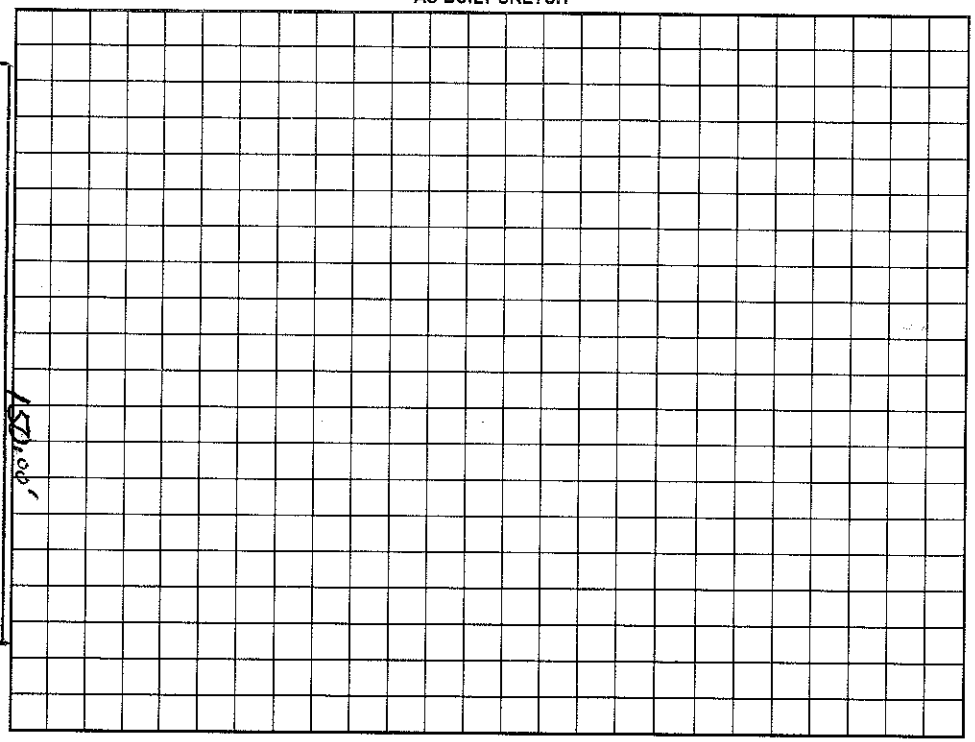

Permit can be suspended or revoked if any false information is supplied toward securing the permit/any unauthorized changes are made to the site/any unauthorized changes are made in the installation of the system. Improvement Permit with plat valid without expiration. Improvement Permit with site plan valid for sixty months. Authorization to Construct is valid for a period equal to that of Improvement Permit – not to exceed sixty months.

Signed: _____ date 12/8/99

Improvement Permit by: _____ date 12-1-99

Authorization to Construct by: _____ date 12-1-99

Installed by: A-1 Backhoe

Operation Permit by: Wesley Sparks R.S. date 3/1/00

Existing System Inspection by: _____ date _____

HEALTH DEPT. COPY: WHITE OWNER COPY (FINAL): YELLOW OWNER COPY (INITIAL): PINK