IREDELL COUNTY HEALTH DEPARTMENT

STATESVILLE 704-878-5305 MOORESVILLE 704-664-5281

CO? 10.00

IMPROVEMENT PERMIT / AUTHORIZATION TO CONSTRUCT / OPERATION PERMIT / EXISTING SYSTEM INSPECTION

PERMIT# 082700 PIN# ~~4961-65-1588~~ pt. 4961-42-7898 DATE October 24, 99

OWNER OR CONTRACTOR Deer Valley Dev. LLC PHONE: Business 664-9080 Home

ADDRESS 255 Rolling Hills Rd. Mooresville

LOCATION I-15-21 N. OTR 1001 (Amity Ostwalt) TR Brawley Rd. TR Doe Meadow Ct. 1st on Right

SUBDIVISION Deer Valley BLOCK / SECTION LOT 12 LOT AREA .90 Ac SITE CLASS. PS DESIGN FLOW 360gpd L.T.A.R. e3

Septic Tank: 1000 Gallons; STB 1012 Date 8-22-99
Pump Tank: Gallons; PT Date
Pump Make: Model Serial No.
Nitrification Field: No Fields Square Feet 1200 Linear Feet 400
No Lines 3 @ 134' Trench Width 36" Max Trench Bottom Depth 36" Gravel Depth 12"

☑ New System ☐ Repair System Type: I, II, III, IV, V, VI
System Description: GRAVITY CONVENTIONAL
Repair System Description: SAME
Maintenance Agreement Required: ☐ Yes ☑ No


☑ House/Mod. Home No. Bedrooms 3
☐ Mobile Home No. Bathrooms 2
☐ Business No. Employees
☐ Other
☐ Slab ☑ Crawl Space ☐ Basement w/plumbing ☐ Basement wo/plumbing

Water Supply: ☑ Individual DRH ~~☐ Public~~ ~~☐ Community~~


Comments/Conditions: MAINTAIN 100' separation between well & Septic System.

Comments/Conditions: Well not installed at time of inspection. 11/29/99 David observed power line trench dissecting Drainfield. CV 12/2/99 Power line removed & drainlines reconnected where severed. MH.

1"=50' INITIAL SITE SKETCH

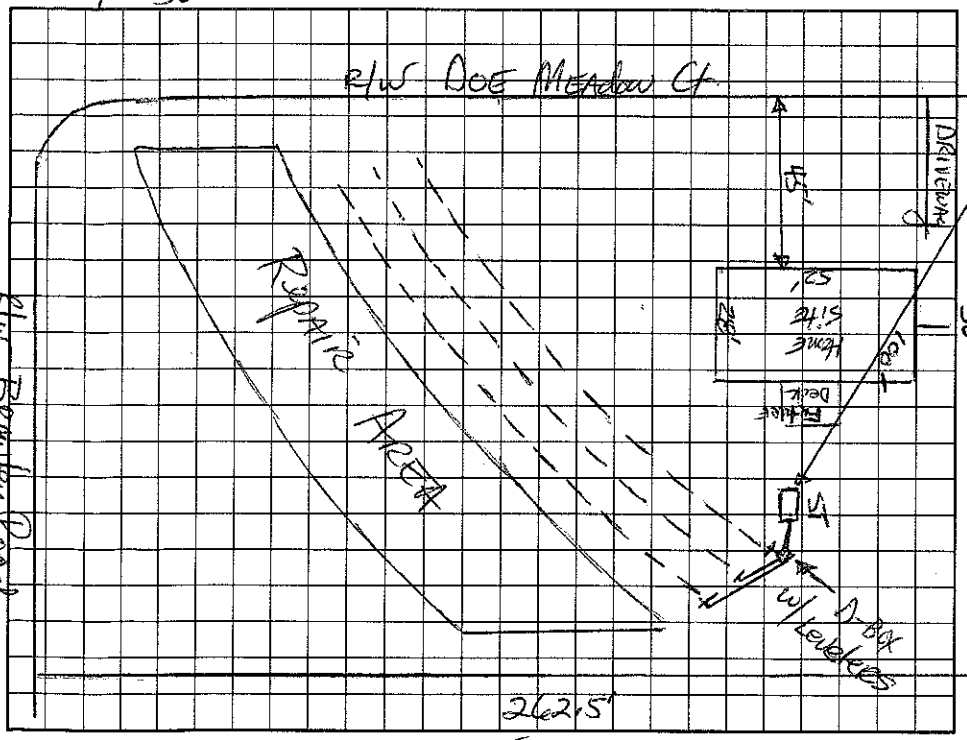

AS BUILT SKETCH

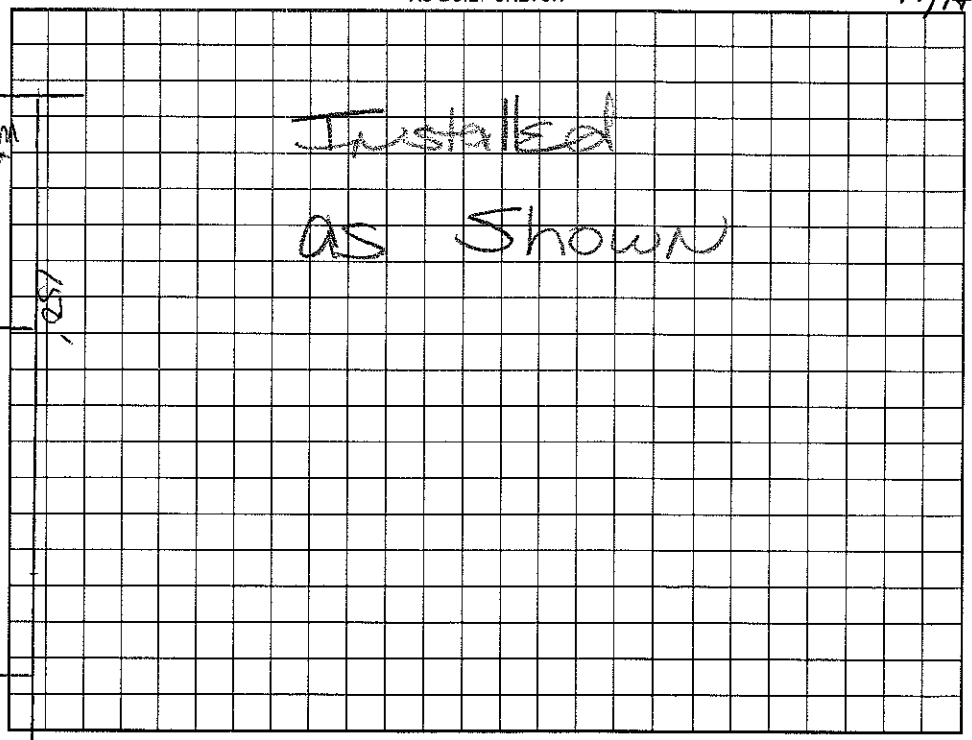

Permit can be suspended or revoked if any false information is supplied toward securing the permit/any unauthorized changes are made to the site/any unauthorized changes are made in the installation of the system. Improvement Permit with plat valid without expiration. Improvement Permit with site plan valid for sixty months. Authorization to Construct is valid for a period equal to that of Improvement Permit – not to exceed sixty months.

Signed: date

Improvement Permit by: date 10-29-99

Authorization to Construct by: date 10-29-99

Installed by: A-1 Backhoe

Operation Permit by: Maria H. H. Dotson date 11/5/99

Existing System Inspection by: date

HEALTH DEPT. COPY: WHITE OWNER COPY (FINAL): YELLOW OWNER COPY (INITIAL): PINK