IREDELL COUNTY HEALTH DEPARTMENT

STATESVILLE 704-878-5305 MOORESVILLE 704-664-5281

IMPROVEMENT PERMIT / AUTHORIZATION TO CONSTRUCT / OPERATION PERMIT / EXISTING SYSTEM INSPECTION

PERMIT# 8870 7 PIN# ~~4761-65-1586-RE~~ 4761-93-0264 DATE 7/26/00

OWNER OR CONTRACTOR DEER VALLEY LLC PHONE: Business 664-9080 Home

ADDRESS 255 ROLLING HILLS DR. MOORESVILLE NC 28117

LOCATION OSWALT AMITY - TR BRAWLEY - TR DEER VALLEY ON CT NEAR END

SUBDIVISION DEERVALLEY BLOCK / SECTION 3 LOT 37 LOT AREA .92 AC SITE CLASS. PS DESIGN FLOW 360 GPD L.T.A.R. .3 gal/ft²

Septic Tank: 1000 Gallons: STB 1012 Date 8/18/01

Pump Tank: Gallons: PT Date

Pump Make: Model Serial No.

Nitrification Field: No Fields 1 Square Feet 900 Linear Feet 300

~~No Lines 4 EA 75'~~ Trench Width 36" Max Trench Bottom Depth 36" Gravel Depth N/A

☑ New System ☐ Repair System Type: I, II, III, IV, V, VI

System Description: GRAVITY ~~25% REDUCTION~~

Repair System Description: SAME

Maintenance Agreement Required: ☐ Yes ☑ No

☑ House/Mod. Home No. Bedrooms 3

☐ Mobile Home No. Bathrooms 2

☐ Business No. Employees

☐ Other


☐ Slab ☑ Crawl Space ☐ Basement w/plumbing ☐ Basement wo/plumbing

Water Supply: ☑ Individual ☐ Public ☐ Community

Comments:/Conditions: ~~2 BDRMS~~ KEEP SUBS 50' FROM WELL

Comments:/Conditions:

INITIAL SITE SKETCH 1"=50'

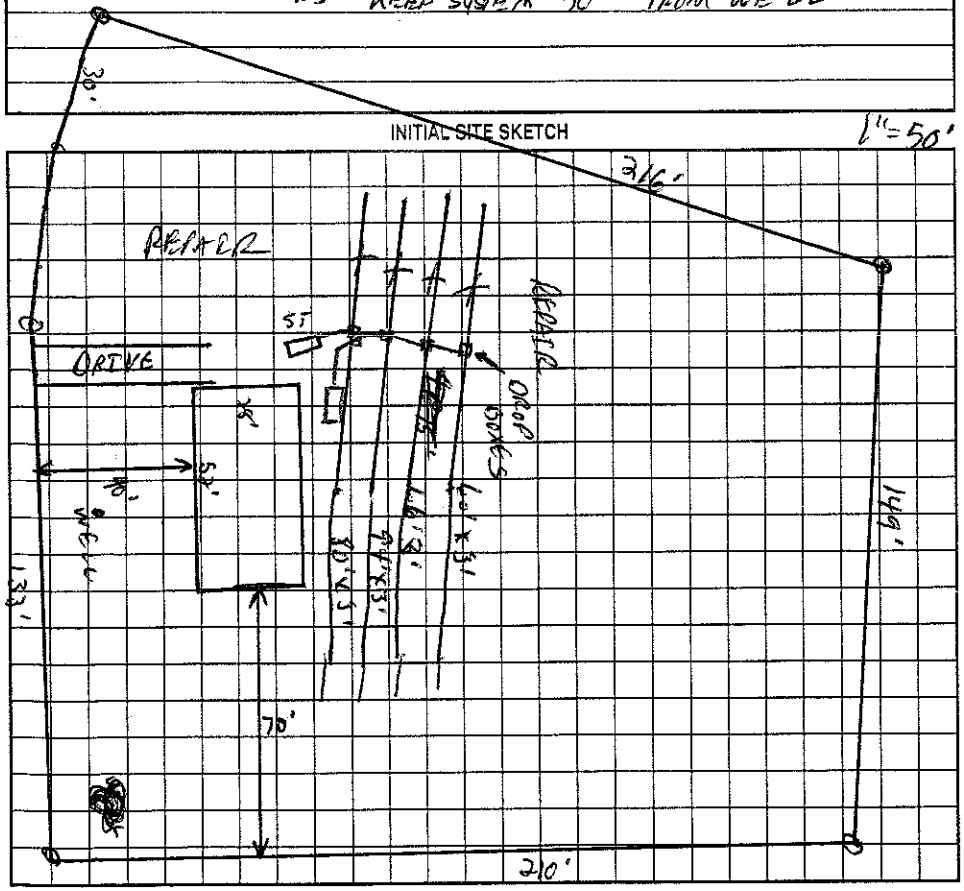

AS BUILT SKETCH

Permit can be suspended or revoked if any false information is supplied toward securing the permit/any unauthorized changes are made to the site/any unauthorized changes are made in the installation of the system. Improvement Permit with plat valid without expiration. Improvement Permit with site plan valid for sixty months. Authorization to Construct is valid for a period equal to that of Improvement Permit – not to exceed sixty months.

Signed: date 8/3/00 Installed by: A-1

Improvement Permit by: C. RS date 7/26/00 Operation Permit by: Wesley Sparks RS date 12/21/01

Authorization to Construct by: C. RS date 7/26/00 Existing System Inspection by: date

HEALTH DEPT. COPY: WHITE OWNER COPY (FINAL): YELLOW OWNER COPY (INITIAL): PINK