IREDELL COUNTY HEALTH DEPARTMENT

STATESVILLE 704-878-5305 — MOORESVILLE 704-664-5281

IMPROVEMENT PERMIT / AUTHORIZATION TO CONSTRUCT / OPERATION PERMIT / EXISTING SYSTEM INSPECTION

PERMIT# 98711 PIN# ~~4761-63-1580-PT~~ 4761-43-0530 DATE 7/26/00

OWNER OR CONTRACTOR DEER VALLEY LLC PHONE: Business 664-9080 Home

ADDRESS 255 ROLLING HILLS DR. MOORESVILLE NC 28117

LOCATION 115N - TR OSWALT AMITY - TR BRAWLEY - TR DEER VALLEY ON RT

SUBDIVISION DEERVALLEY BLOCK / SECTION 3 LOT 37 LOT AREA 1.07AC SITE CLASS. PS DESIGN FLOW 360GPD L.T.A.R. ~~.35~~ .44

Septic Tank: 1000 Gallons; STB 794 Date 4/5/00
Pump Tank: ____ Gallons; PT ____ Date ____
Pump Make: ____ Model ____ Serial No. ____
Nitrification Field: No Fields 1 Square Feet 1200 Linear Feet 400
No Lines 6@67' Trench Width 36" Max Trench Bottom Depth 36" Gravel Depth 12"

☑ New System ☐ Repair System Type: I (II) III, IV, V, VI
System Description: GRAVITY CONVENTIONAL
Repair System Description: SAME
Maintenance Agreement Required: ☐ Yes ☑ No


☑ House/Mod. Home No. Bedrooms 3
☑ Mobile Home No. Bathrooms 2
☐ Business No. Employees ____
☐ Other ____
☐ Slab ☑ Crawl Space ☐ Basement w/plumbing ☐ Basement wo/plumbing

Water Supply: ☐ Individual ☐ Public ☐ Community


Comments:/Conditions:

Comments:/Conditions:

INITIAL SITE SKETCH

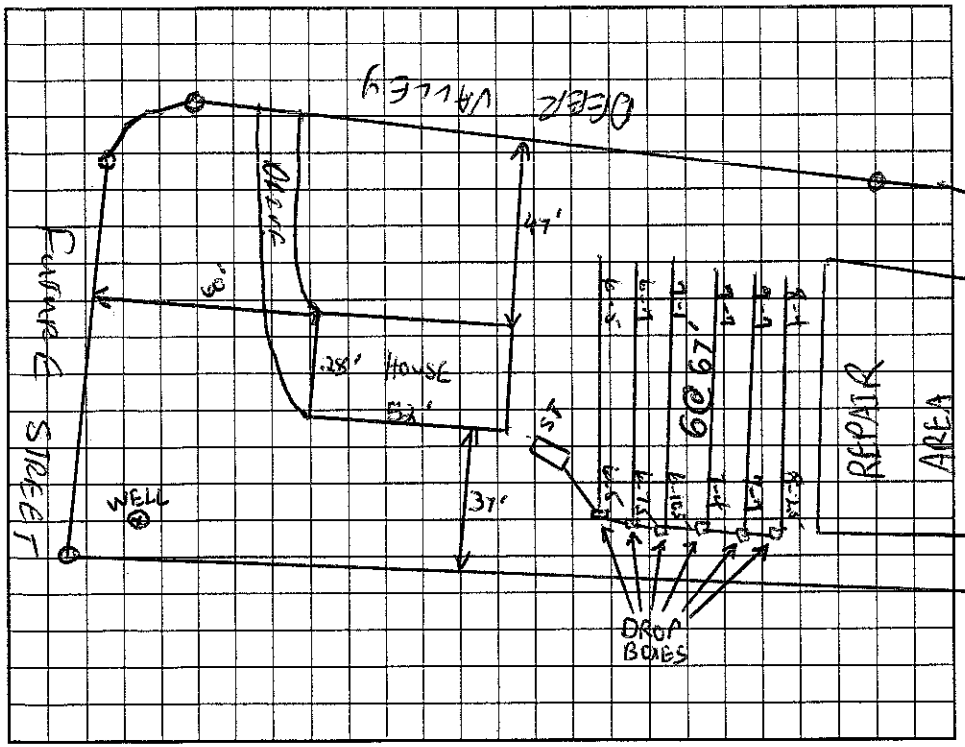

AS BUILT SKETCH

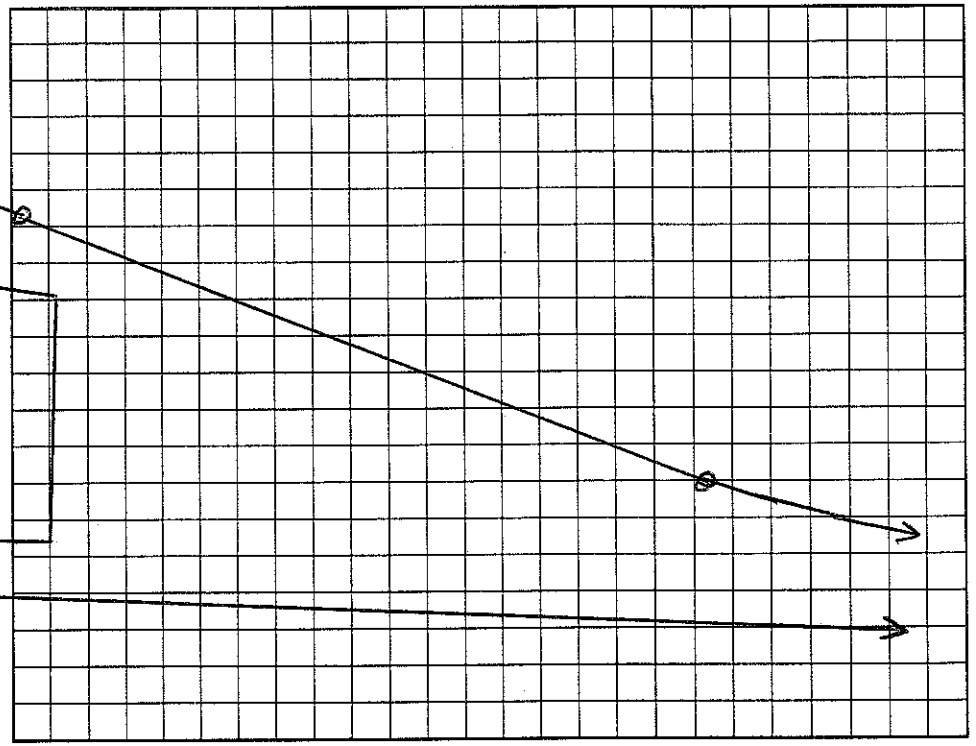

Permit can be suspended or revoked if any false information is supplied toward securing the permit/any unauthorized changes are made to the site/any unauthorized changes are made in the installation of the system. Improvement Permit with plan valid without expiration. Improvement Permit with site plan valid for sixty months. Authorization to Construct is valid for a period equal to that of Improvement Permit – not to exceed sixty months.

Signed: [signature] date 8/3/00 Installed by: Gerald Tucker

Improvement Permit by: C. [signature] RS date 7/26/00 Operation Permit by: Wesley Sparks RS. date 12/5/00

Authorization to Construct by: C. [signature] RS date 7/26/00 Existing System Inspection by: ____ date ____

HEALTH DEPT. COPY: WHITE OWNER COPY (FINAL): YELLOW OWNER COPY (INITIAL): PINK