3500

IREDELL COUNTY HEALTH DEPARTMENT

STATESVILLE 704-878-5305 MOORESVILLE 704-664-5281

IMPROVEMENT PERMIT / AUTHORIZATION TO CONSTRUCT / OPERATION PERMIT / EXISTING SYSTEM INSPECTION

PERMIT# 082694 PIN# ~~4761-65-1580 (pt)~~ 4761-43-1053 DATE March 17, 2000

OWNER OR CONTRACTOR Deer Valley Dev Group LLC PHONE: Business 664-9080 Home

ADDRESS 255 Rolling Hills Rd. Mooresville

LOCATION 116-21N TR Ostwalt-Amity TR Brawley TR ~~Rollingview Ct.~~ WILKINS WAY at end

SUBDIVISION Deer Valley BLOCK / SECTION 2 LOT 7 LOT AREA .93AC SITE CLASS. PS** DESIGN FLOW 360gpd L.T.A.R. .25

Septic Tank: 1000 Gallons; STB Date 12/18/01

Pump Tank: Gallons; PT Date

Pump Make: Model Serial No.

Nitrification Field: No Fields 1 Square Feet 1200 Linear Feet 400

No Lines 3 Trench Width 36" Max Trench Bottom Depth 24"

☑ New System ☐ Repair System Type: I. II. III. IV. V. VI.

System Description: Shallow Gravity Innovative

Repair System Description: PM Shallow Innov. on SFE Located on Lot 6 **

Maintenance Agreement Required: ☐ Yes ☑ No

Gravel Depth NA ☐ Slab ☑ Crawl Space ☐ Basement w/plumbing ☐ Basement wo/plumbing

☐ House/Mod. Home No. Bedrooms 3

☐ Mobile Home No. Bathrooms 2

☐ Business No. Employees


☐ Other

Water Supply: ☑ Individual ☐ Public ☐ Community

Comments:/Conditions: * ONE INSPECTION PORT PER LATERAL.

Comments:/Conditions: EZ Lay installed

INITIAL SITE SKETCH

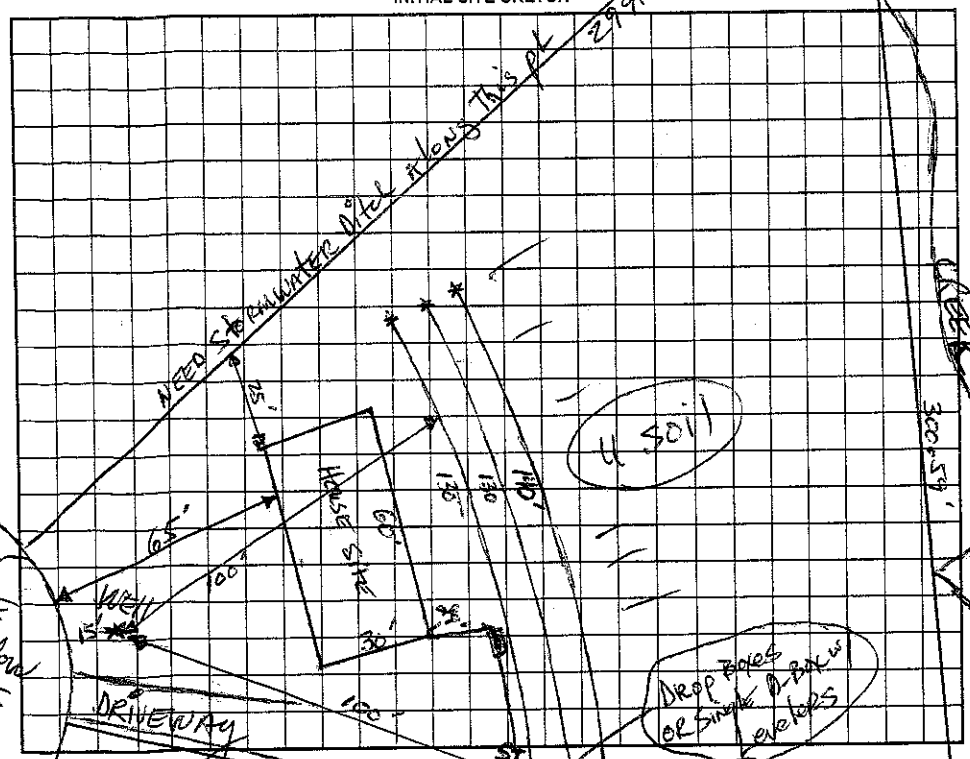

AS BUILT SKETCH

Permit can be suspended or revoked if any false information is supplied toward securing the permit/any unauthorized changes are made to the site/any unauthorized changes are made in the installation of the system. Improvement Permit with plat valid without expiration. Improvement Permit with site plan valid for sixty months. Authorization to Construct is valid for a period equal to that of Improvement Permit – not to exceed sixty months.

Signed: Dave Q 244451 date 3/23/00

Improvement Permit by: Mark Thompson RS date 3-17-00

Authorization to Construct by: Wesley Sparks R.S. date 5/1/02

Installed by: A-1 Backhoe

Operation Permit by: Wesley Sparks R.S. date 5/2/02

Existing System Inspection by: date

HEALTH DEPT. COPY: WHITE OWNER COPY (FINAL): YELLOW OWNER COPY (INITIAL): PINK