IREDELL COUNTY HEALTH DEPARTMENT

STATESVILLE 704-878-5305 50.00 Paid MOORESVILLE 704-664-5281

IMPROVEMENT PERMIT / AUTHORIZATION TO CONSTRUCT / OPERATION PERMIT / EXISTING SYSTEM INSPECTION

PERMIT# 088706 PIN# ~~4761651580 PT~~ 4761-43-1396 DATE 3/18/02

OWNER OR CONTRACTOR DEER VALLEY LLC / LEADER HOMES PHONE: Business 664-9080 Home

ADDRESS 255 ROLLING HILLS DRIVE MOORESVILLE

LOCATION OSWALT AMITY - TR BRAWLEY RD - TR DEERVALLEY DR. ON LT

SUBDIVISION DEERVALLEY BLOCK / SECTION 3 LOT 32 LOT AREA .91 AC SITE CLASS RS DESIGN FLOW 480 GPD L.T.A.R. .36 GPD/FT²

Septic Tank: 1006 Gallons; STB 1012 Date 9/19/01
Pump Tank: Gallons; PT Date
Pump Make: Model Serial No.
Nitrification Field: No Fields 1 Square Feet 1200 Linear Feet 400
No Lines ~~2~~ Trench Width 36" Max Trench Bottom Depth 24" Gravel Depth N/A

☑ New System ☐ Repair System Type: I, II, (III), IV, V, VI
System Description: GRAVITY 25% REDUCTION
Repair System Description: SAME
Maintenance Agreement Required: ☐ Yes ☑ No

☑ House/Mod. Home No. Bedrooms 4
☐ Mobile Home No. Bathrooms 4
☐ Business No. Employees
☐ Other


☐ Slab ☑ Crawl Space ☐ Basement w/plumbing ☐ Basement wo/plumbing

Water Supply: ☑ Individual ☐ Public ☐ Community

Comments:/Conditions: V 3@133'

Comments:/Conditions:

INITIAL SITE SKETCH

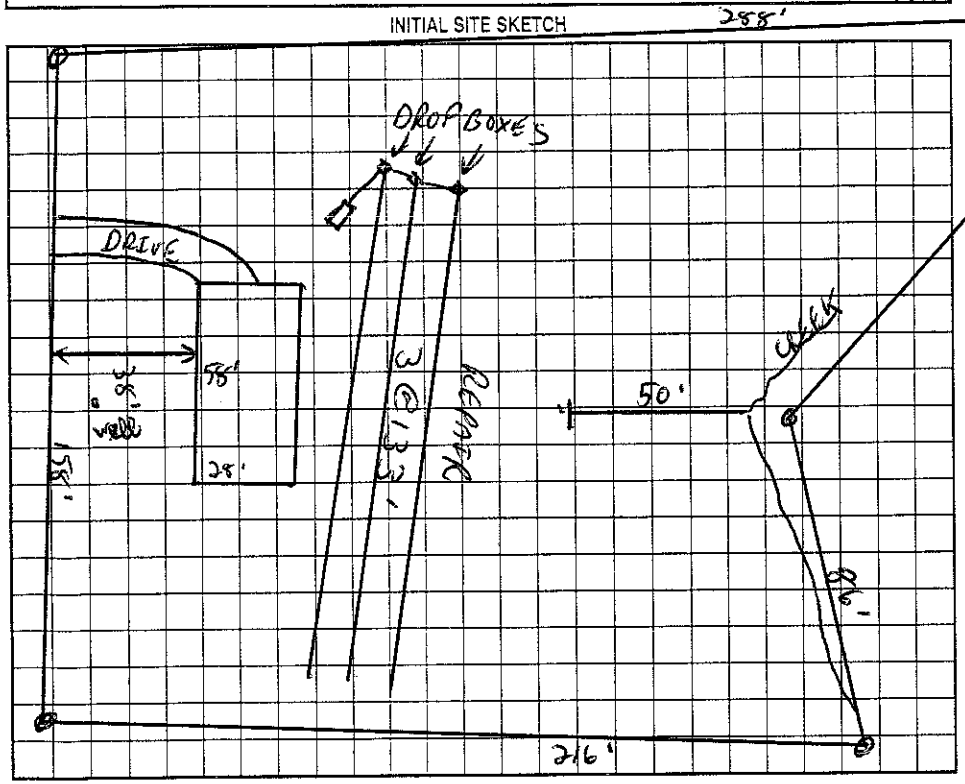

AS BUILT SKETCH

Permit can be suspended or revoked if any false information is supplied toward securing the permit/any unauthorized changes are made to the site/any unauthorized changes are made in the installation of the system. Improvement Permit with plat valid without expiration. Improvement Permit with site plan valid for sixty months. Authorization to Construct is valid for a period equal to that of Improvement Permit – not to exceed sixty months.

Signed: Dennis Dallas date 3/26/02 Installed by: A-1 Backhoe

Improvement Permit by: C. Shaw RS date 3/18/02 Operation Permit by: RS date 3/26/02

Authorization to Construct by: C. Shaw RS date 3/18/02 Existing System Inspection by: date

HEALTH DEPT. COPY: WHITE OWNER COPY (FINAL): YELLOW OWNER COPY (INITIAL): PINK