IREDELL COUNTY HEALTH DEPARTMENT

STATESVILLE 704-878-5305 MOORESVILLE 704-664-5281

IMPROVEMENT PERMIT / AUTHORIZATION TO CONSTRUCT / OPERATION PERMIT / EXISTING SYSTEM INSPECTION

PERMIT# 88704 PIN# ~~4761-65-1580~~ 4761-43-3589 DATE 3/27/02

OWNER OR CONTRACTOR Deer Valley LLC PHONE: Business 664-7080 Home

ADDRESS 255 Rolling Hills Dr. Mooresville NC 28115

LOCATION Oswalt Amity, TR Brawley TR Deer Valley on Lt.

SUBDIVISION Deer Valley BLOCK / SECTION 3 LOT 30 LOT AREA 0.9 Ac SITE CLASS. PS DESIGN FLOW 450 L.T.A.R. 0.3

Septic Tank: 1000 Gallons; STB 1012 Date 3/15/02

Pump Tank: 1000 Gallons; PT 17 Date 7/14/00

Pump Make: Myers Model MW50-42 Serial No.

Nitrification Field: No Fields 1 Square Feet 1200 Linear Feet 400

No Lines 4 @ 100 Trench Width 36" Max Trench Bottom Depth 36" Gravel Depth —

☒ New System ☐ Repair System Type: I, II, (III), IV, V, VI

System Description: Pump 25% Reduction

Repair System Description: Pump Panel

Maintenance Agreement Required: ☐ Yes ☒ No

☐ House/Mod. Home ☒ Mobile Home ☐ Business ☐ Other

No. Bedrooms 4 No. Bathrooms 4 No. Employees

☐ Slab ☒ Crawl Space ☐ Basement w/plumbing ☐ Basement wo/plumbing


Water Supply: ☒ Individual ☐ Public ☐ Community

Comments:/Conditions:


Comments:/Conditions:

Drive is on Lt. Side

INITIAL SITE SKETCH

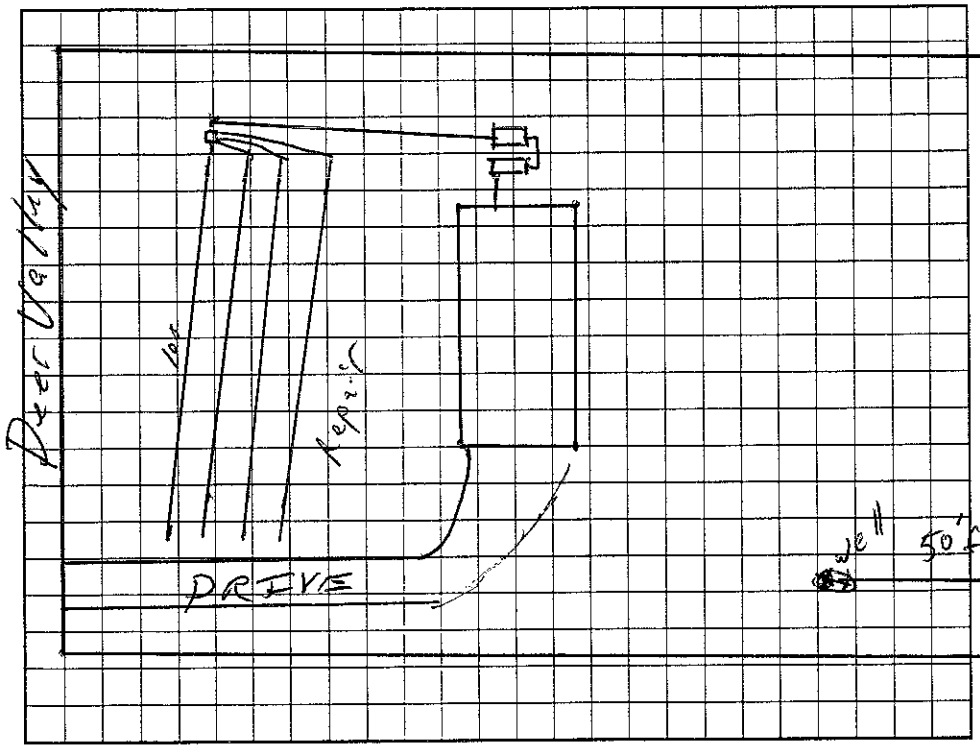

AS BUILT SKETCH

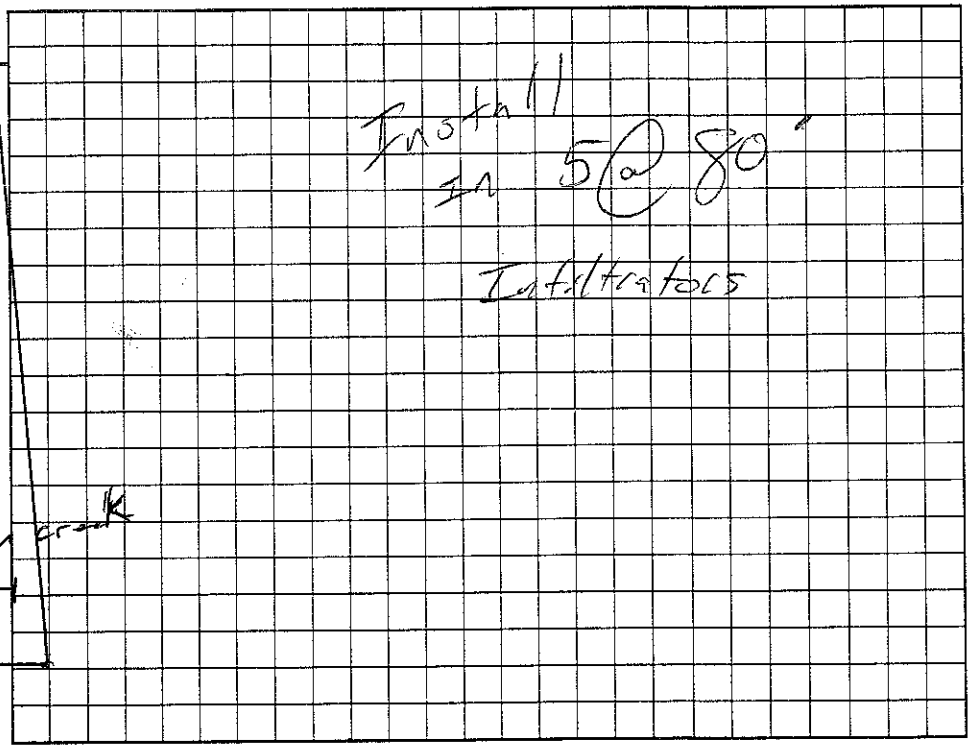

Permit can be suspended or revoked if any false information is supplied toward securing the permit/any unauthorized changes are made to the site/any unauthorized changes are made in the installation of the system. Improvement Permit with plat valid without expiration. Improvement Permit with site plan valid for sixty months. Authorization to Construct is valid for a period equal to that of Improvement Permit – not to exceed sixty months.

Signed: Dennis Gallion date 3-27-02 Installed by: A-1 Backhoe

Improvement Permit by: RS date 3/27/02 Operation Permit by: RS date 8/16/02

Authorization to Construct by: RS date 3/27/02 Existing System Inspection by: date

HEALTH DEPT. COPY: WHITE OWNER COPY (FINAL): YELLOW OWNER COPY (INITIAL): PINK