IREDELL COUNTY HEALTH DEPARTMENT

STATESVILLE 704-878-5305 MOORESVILLE 704-664-5281

IMPROVEMENT PERMIT / AUTHORIZATION TO CONSTRUCT / OPERATION PERMIT / EXISTING SYSTEM INSPECTION

PERMIT# 88712 PIN# ~~4761-65-1580 PT~~ 4761-43-3925 DATE 6/27/00

OWNER OR CONTRACTOR DEER VALLEY LLC PHONE: Business Home 664-9080

ADDRESS 255 ROLLING HILLS DRIVE

LOCATION 21 N- TR OSWALT AMITY - TR BRAWLEY - TR DEER VALLEY - ON RT

SUBDIVISION DEER VALLEY BLOCK / SECTION 3 LOT 38 LOT AREA .95AC SITE CLASS. PS DESIGN FLOW 480GPD L.T.A.R. .36GPD/FT

Septic Tank: 1000 Gallons; STB 1012 Date 9/12/00

Pump Tank: Gallons; PT Date

Pump Make: Model Serial No.

Nitrification Field: No Fields 1 Square Feet 1200 Linear Feet 400

No Lines 4@100' Trench Width 36" Max Trench Bottom Depth 36" Gravel Depth N/A

☑ New System ☐ Repair System Type: I, II, III, IV, V, VI

System Description: GRAVITY ~~250 LF REDUCTION~~

Repair System Description: GRAV/PUMP SAME

Maintenance Agreement Required: ☐ Yes ☑ No

☑ House/Mod. Home ☑ Mobile Home ☐ Business ☐ Other

No. Bedrooms ~~4~~ 3 No. Bathrooms 2 No. Employees

Water Supply: ☑ ~~Individual~~ ☐ Public ☐ Community


☐ Slab ☑ Crawl Space ☐ Basement w/plumbing ☐ Basement wo/plumbing

Comments:/Conditions:


Comments:/Conditions:

9/12/00 - Change to 400' of Gravity Conventional - AWS

INITIAL SITE SKETCH 1"=50'

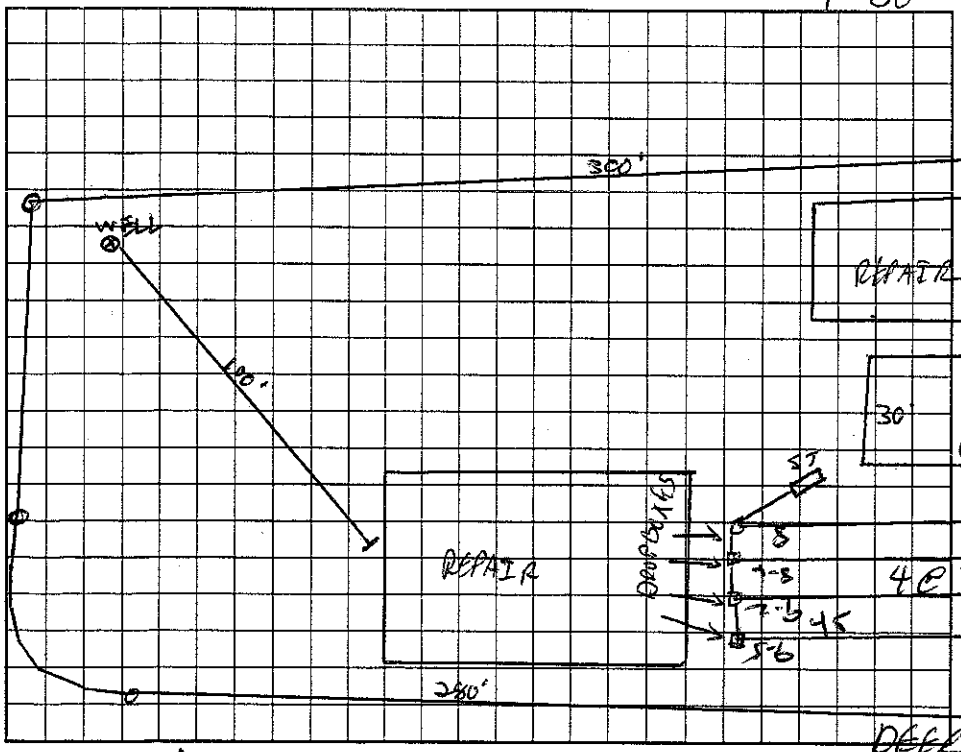

AS BUILT SKETCH

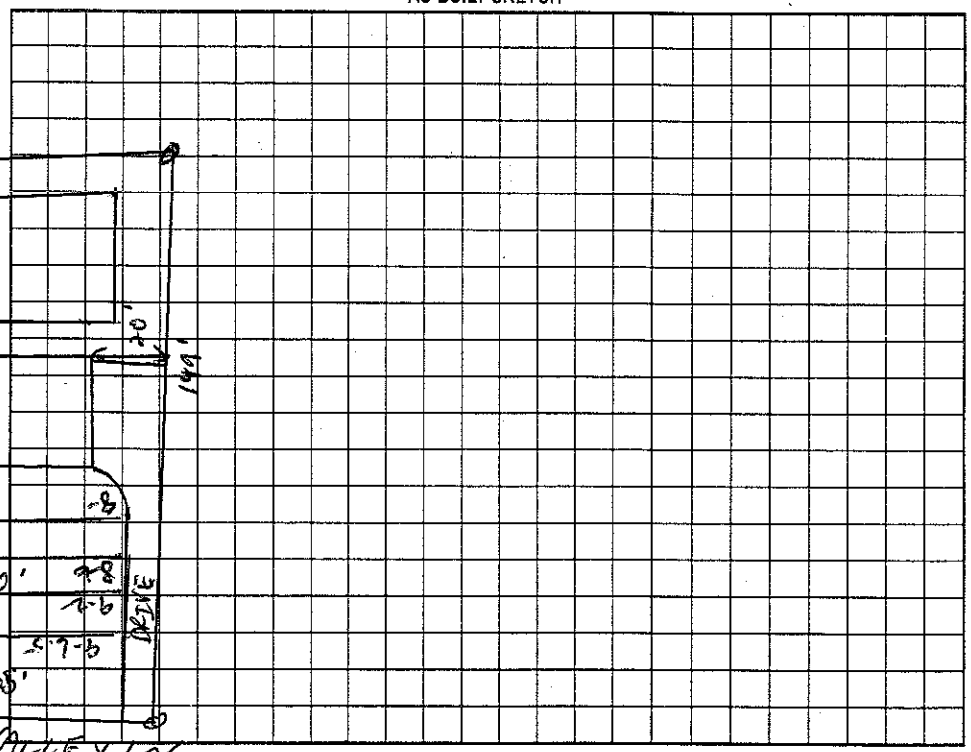

Permit can be suspended or revoked if any false information is supplied toward securing the permit/any unauthorized changes are made to the site/any unauthorized changes are made in the installation of the system. Improvement Permit with plat valid without expiration. Improvement Permit with site plan valid for sixty months. Authorization to Construct is valid for a period equal to that of Improvement Permit – not to exceed sixty months.

Signed: Lance Mc date

Improvement Permit by: E. [illegible] RS date 6/27/00

Authorization to Construct by: C. [illegible] RS date 6/28/00

Installed by: A-1 Backhoe

Operation Permit by: Wesley Sparkes date 9/20/00

Existing System Inspection by: date

HEALTH DEPT. COPY: WHITE OWNER COPY (FINAL): YELLOW OWNER COPY (INITIAL): PINK