Site Address: 159 Deer Valley Dr., Cleveland, NC 27013

IREDELL COUNTY HEALTH DEPARTMENT

STATESVILLE 704-878-5305 MOORESVILLE 704-664-5281

IMPROVEMENT PERMIT / AUTHORIZATION TO CONSTRUCT / OPERATION PERMIT / EXISTING SYSTEM INSPECTION

PERMIT# 88703 PIN# ~~4761-65-1580-PI~~ 4761-43-4763 DATE 8/2/00

OWNER OR CONTRACTOR DEER VALLEY LLC / Leader Lot 2-84 PHONE: Business 664-9080 Home

ADDRESS 255 ROLLING HILLS DR. MOORESVILLE

LOCATION DSWALT AMITY - TR BRANLEY - TR DEER VALLEY - ON LT

SUBDIVISION DEERVALLEY BLOCK / SECTION 3 LOT 29 LOT AREA .9AC SITE CLASS. RS DESIGN FLOW 360GPD L.T.A.R. .3gpd/ft²

Septic Tank: 1000 Gallons; STB 1012 Date 7/16/01

Pump Tank: 1000 Gallons; PT 17 Date 6/17/01

Pump Make: HYDROMATIC Model SHEF 50 A1 Serial No. 9/6/01

Nitrification Field: No Fields 1 Square Feet 900 Linear Feet 300

No Lines 3@100' Trench Width 36" Max Trench Bottom Depth 36" Gravel Depth 1/4

☒ New System ☐ Repair System Type: I, II, III, IV, V, VI

System Description: PUMP 25% REDUCTION

Repair System Description: PUMP TANK

Maintenance Agreement Required: ☐ Yes ☒ No

☒ House/Mod. Home No. Bedrooms 3

☒ Mobile Home No. Bathrooms 3

☐ Business No. Employees

☐ Other


Water Supply: ☒ Individual ☐ Public ☐ Community

☐ Slab ☒ Crawl Space ☐ Basement w/plumbing ☐ Basement w/o plumbing

Comments:/Conditions:

Comments:/Conditions: Tanks, Lines, Manifold installed as shown on AC.

INITIAL SITE SKETCH 1" = 50'

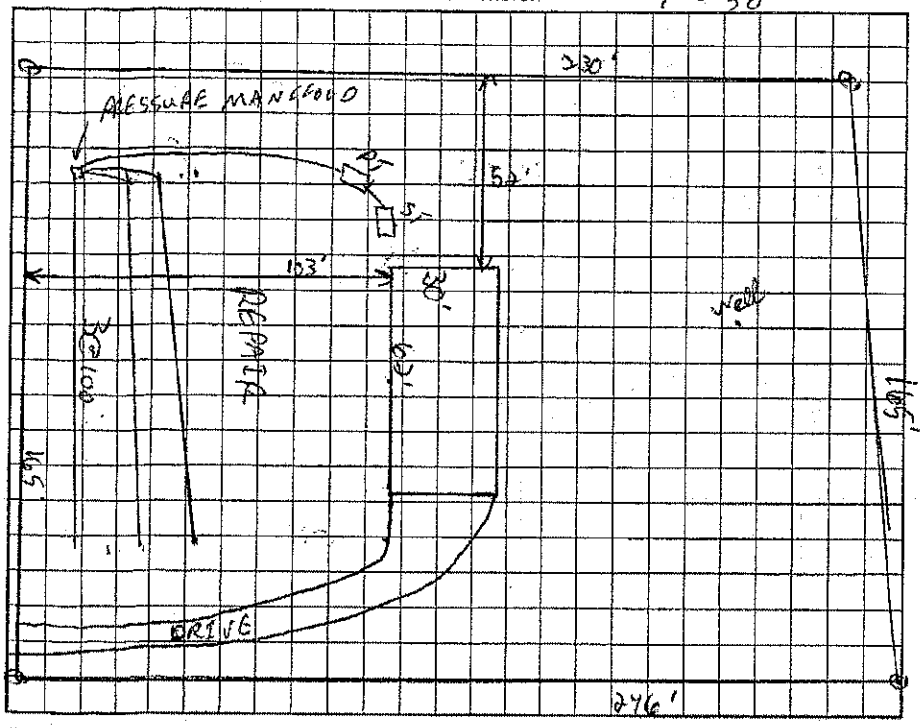

AS BUILT SKETCH

DEERVALLEY DR.

Permit can be suspended or revoked if any false information is supplied toward securing the permit/any unauthorized changes are made to the site/any unauthorized changes are made in the installation of the system. Improvement Permit with plat valid without expiration. Improvement Permit with site plan valid for sixty months. Authorization to Construct is valid for a period equal to that of Improvement Permit – not to exceed sixty months.

Signed: [signature] date 8/3/00 Installed by: A-1 Backhoe

Improvement Permit by: [signature] RS date 8/2/00 Operation Permit by: [signature] RS. date 11/6/2001

Authorization to Construct by: [signature] RS date 8/2/00 Existing System Inspection by: date

HEALTH DEPT. COPY: WHITE OWNER COPY (FINAL): YELLOW OWNER COPY (INITIAL): PINK