IREDELL COUNTY HEALTH DEPARTMENT

STATESVILLE 704-878-5305 MOORESVILLE 704-664-5281

IMPROVEMENT PERMIT / AUTHORIZATION TO CONSTRUCT / OPERATION PERMIT / EXISTING SYSTEM INSPECTION

PERMIT# 88703 PIN# 4761-65-1580 PT 4761-43-4763 DATE 8/2/00

OWNER OR CONTRACTOR DEER VALLEY LLC / Leader 6662-84 PHONE: Business 664-9080 Home

ADDRESS 255 ROLLING HILLS DR. MOORESVILLE

LOCATION SWALT AMIY - TR BRANLEY - TR DEER VALLEY - ON LT

SUBDIVISION DEERVALLEY BLOCK / SECTION 3 LOT 29 LOT AREA .9AC SITE CLASS. RS DESIGN FLOW 360GPD L.T.A.R. .3gal/ft²

Septic Tank: 1000 Gallons; STB 1012 Date 7/16/01
Pump Tank: 1000 Gallons; PT 17 Date 6/17/01
Pump Make: HYDROMATIC Model SHEF 50A1 Serial No. 9/6/01
Nitrification Field: No Fields 1 Square Feet 900 Linear Feet 300
No Lines 3@100' Trench Width 36" Max Trench Bottom Depth 36" Gravel Depth N/A

☑ New System ☐ Repair System Type: I, II, (III), IV, V, VI
System Description: PUMP 25% REDUCTION
Repair System Description: PUMP SAME
Maintenance Agreement Required: ☐ Yes ☐ No

☑ House/Mod. Home No. Bedrooms 3
☑ Mobile Home No. Bathrooms 3
☐ Business No. Employees
☐ Other


☐ Slab ☑ Crawl Space ☐ Basement w/plumbing ☐ Basement wo/plumbing

Water Supply: ☑ Individual ☐ Public ☐ Community

Comments:/Conditions:

Comments:/Conditions: Tanks, Lines, Manifold installed as shown on AC.

INITIAL SITE SKETCH 1" = 50'

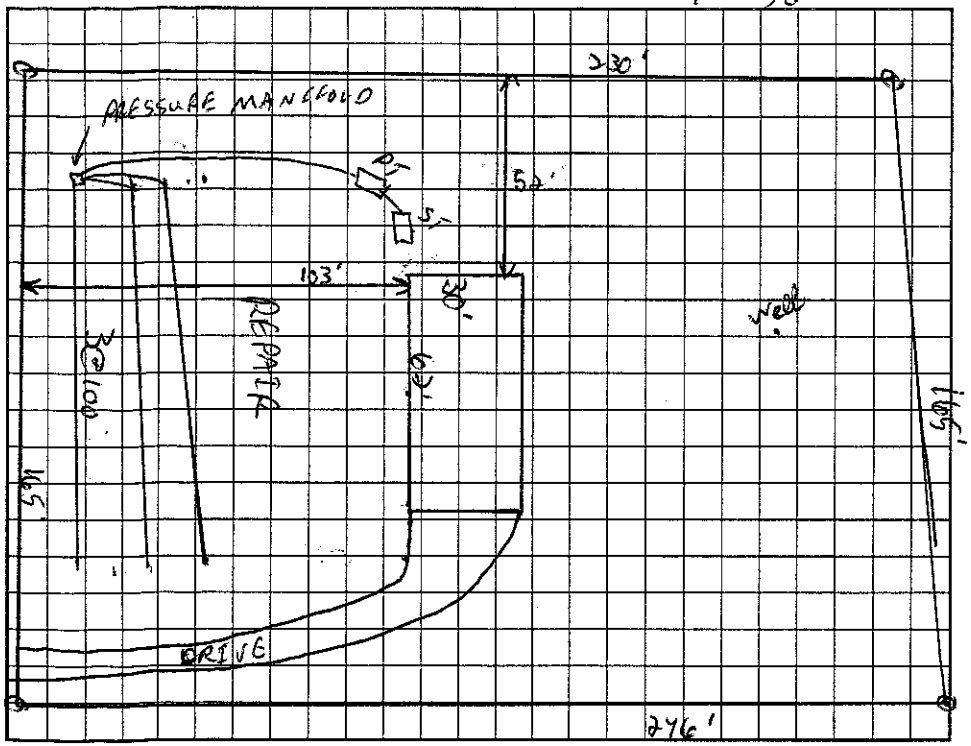

AS BUILT SKETCH

DEERVALLEY 02.

Permit can be suspended or revoked if any false information is supplied toward securing the permit/any unauthorized changes are made to the site/any unauthorized changes are made in the installation of the system. Improvement Permit with plat valid without expiration. Improvement Permit with site plan valid for sixty months. Authorization to Construct is valid for a period equal to that of Improvement Permit – not to exceed sixty months.

Signed: [signature] date 8/3/00 Installed by: A-1 Backhoe

Improvement Permit by: C. [signature] RS date 8/2/00 Operation Permit by: Maria H. Dotson RS date 11/6/2001

Authorization to Construct by: C. [signature] RS date 8/2/00 Existing System Inspection by: date

HEALTH DEPT. COPY: WHITE OWNER COPY (FINAL): YELLOW OWNER COPY (INITIAL): PINK