IREDELL COUNTY HEALTH DEPARTMENT

STATESVILLE 704-878-5305 MOORESVILLE 704-664-5281

2:00

IMPROVEMENT PERMIT / AUTHORIZATION TO CONSTRUCT / OPERATION PERMIT / EXISTING SYSTEM INSPECTION

PERMIT# 082704 PIN# 4761-65-1580 (pt) 4761-43-7239 DATE March 20, 00

OWNER OR CONTRACTOR Deer Valley Dev. Group LLC PHONE: Business 664-9080 Home

ADDRESS 255 Rolling Hills Rd. Mooresville

LOCATION 115-2 LN TR Estault-Amity Rd. TR Brawley TR ~~Estault~~ Blacks Run ON left

SUBDIVISION Deer Valley BLOCK / SECTION LOT 16 LOT AREA 1.68Ac SITE CLASS. PS SFE DESIGN FLOW 360gpd L.T.A.R. .83 SFE

Septic Tank: 1000 Gallons; STB 794 Date 2-9-00

Pump Tank: 1000 Gallons; PT 283 Date 10-27-00

Pump Make: Mowas Model WEO-311 Serial No. L005 64499

Nitrification Field: No Fields 1 Square Feet 1200 Linear Feet 400

No Lines 3 Trench Width 36" Max Trench Bottom Depth 36" Gravel Depth 12"

☑ New System ☐ Repair System Type: I, II, III, IV, V, VI

System Description: PM - CONVENTIONAL ON ESMT.

Repair System Description: PM - INNOVATIVE

Maintenance Agreement Required: ☐ Yes ☑ No

☑ House/Mod. Home No. Bedrooms 3

☐ Mobile Home No. Bathrooms 2

☐ Business No. Employees

☐ Other


☐ Slab ☑ Crawl Space ☐ Basement w/plumbing ☐ Basement wo/plumbing

Water Supply: ☑ Individual ☐ Public ☐ Community


Comments:/Conditions: MAINTAIN 100' SEPARATION between Septic & pump tanks to all well locations.

Comments:/Conditions: Filter not installed yet. Tanks & lines checked 12/21/2000 MK

INITIAL SITE SKETCH (1"=50')

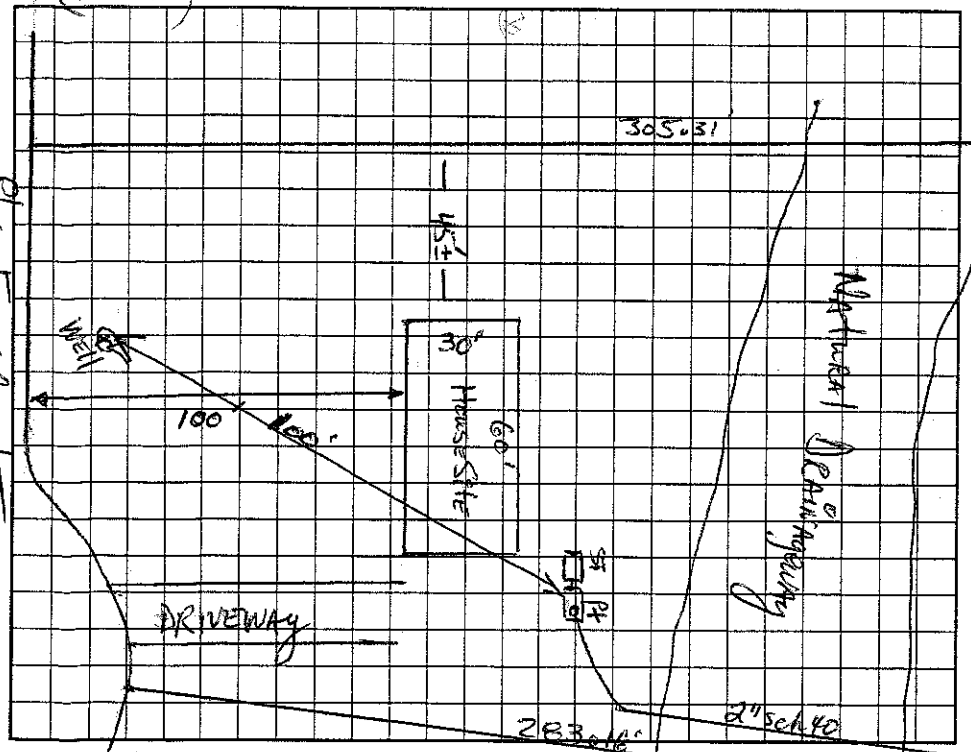

AS BUILT SKETCH

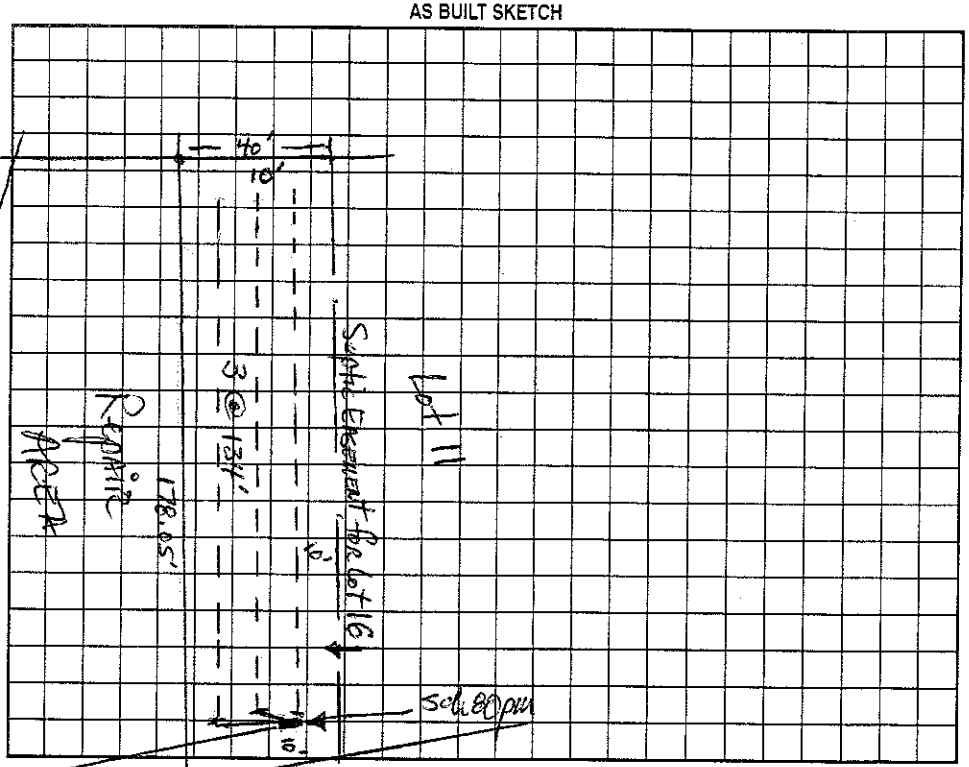

Permit can be suspended or revoked if any false information is supplied toward securing the permit/any unauthorized changes are made to the site/any unauthorized changes are made in the installation of the system. Improvement Permit with plat valid without expiration. Improvement Permit with site plan valid for sixty months. Authorization to Construct is valid for a period equal to that of Improvement Permit – not to exceed sixty months.

Signed: Lane E McKnight date 3/23/00 Installed by: Craig Thompson

Improvement Permit by: Wade Thomas, RS date 3-20-00 Operation Permit by: Wesley Sparks RS date 2/6/01

Authorization to Construct by: Wesley Sparks RS. date 11/30/00 Existing System Inspection by: date

HEALTH DEPT. COPY: WHITE OWNER COPY (FINAL): YELLOW OWNER COPY (INITIAL): PINK