IREDELL COUNTY HEALTH DEPARTMENT

STATESVILLE 704-878-5305 MOORESVILLE 704-664-5281

IMPROVEMENT PERMIT / AUTHORIZATION TO CONSTRUCT / OPERATION PERMIT / EXISTING SYSTEM INSPECTION

PERMIT# 88700 PIN# 4761651580PT 4761438947 DATE 11/15/2000

OWNER OR CONTRACTOR Deer Valley LLC / Leader Homes PHONE: Business _____ Home _____

ADDRESS _____

LOCATION _____

SUBDIVISION Deer Valley BLOCK / SECTION _____ LOT 26 LOT AREA 2.48 Acre SITE CLASS. PS DESIGN FLOW 360 gal. T.A.R. .3

Septic Tank: 1000 Gallons; STB 1012 Date 9-10-2000
Pump Tank: _____ Gallons; PT _____ Date _____
Pump Make: _____ Model _____ Serial No. _____
Nitrification Field: No Fields 1 Square Feet 1200 Linear Feet 400
No Lines 5 Trench Width 36" Max Trench Bottom Depth 36" Gravel Depth 12"

☒ New System ☐ Repair System Type: I, II, III, IV, V, VI
System Description: Gravity - Convent.
Repair System Description: _____
Maintenance Agreement Required: ☐ Yes ☒ No


☐ House/Mod. Home No. Bedrooms 3
☒ Mobile Home No. Bathrooms 3
☐ Business No. Employees _____
☐ Other _____
☐ Slab ☒ Crawl Space ☐ Basement w/plumbing ☐ Basement wo/plumbing

Water Supply: ☒ Individual ☐ Public ☐ Community

Comments:/Conditions: 50' to Neighbor's Well

Comments:/Conditions: Polylock Filter installed

INITIAL SITE SKETCH

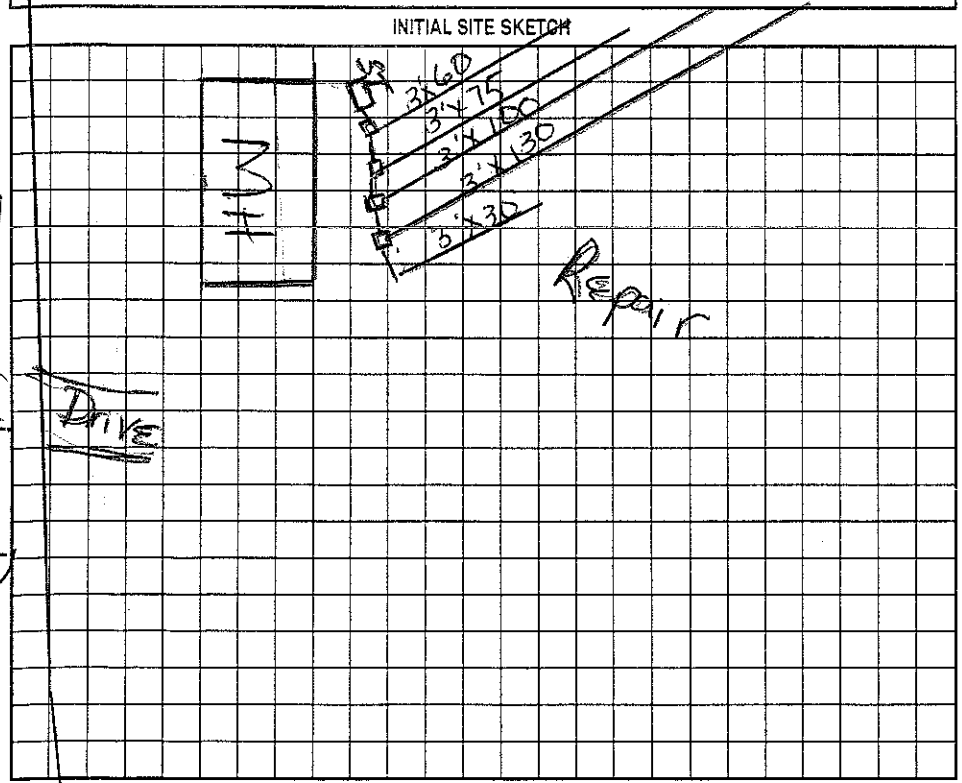

AS BUILT SKETCH

Permit can be suspended or revoked if any false information is supplied toward securing the permit/any unauthorized changes are made to the site/any unauthorized changes are made in the installation of the system. Improvement Permit with plat valid without expiration. Improvement Permit with site plan valid for sixty months. Authorization to Construct is valid for a period equal to that of Improvement Permit – not to exceed sixty months.

Signed: _____ date _____ Installed by: A-1 Backhoe

Improvement Permit by: _____ date _____ Operation Permit by: Maria H. Dotson RS date 11/15/2000

Authorization to Construct by: _____ date _____ Existing System Inspection by: _____ date _____

HEALTH DEPT. COPY: WHITE OWNER COPY (FINAL): YELLOW OWNER COPY (INITIAL): PINK

IREDELL COUNTY HEALTH DEPARTMENT

STATESVILLE 704-878-5305 — MOORESVILLE 704-664-5281

IMPROVEMENT PERMIT / AUTHORIZATION TO CONSTRUCT / OPERATION PERMIT / EXISTING SYSTEM INSPECTION

PERMIT# 88700 PIN# ~~4761-65-1580 PF~~ 4761-43-8947 DATE 8/2/00

OWNER OR CONTRACTOR DEERVALLEY LLC / Leader Home PHONE: Business 664-9080 Home

ADDRESS 255 ROLLING HILLS DR. / MOORESVILLE NC 28117

LOCATION OSWALT AMITY - TR BRAWLEY - TR DEER VALLEY -

SUBDIVISION DEER VALLEY BLOCK / SECTION 3 LOT 26 LOT AREA 2.48AC SITE CLASS. BS DESIGN FLOW 360GPD L.T.A.R. .36GPD/FT²

Septic Tank: 1000 Gallons; STB 1012 Date 9-10-2000
Pump Tank: ____ Gallons; PT ____ Date ____
Pump Make: ____ Model ____ Serial No. ____
Nitrification Field: No Fields 1 Square Feet 1200 Linear Feet 400
No Lines 4@100' Trench Width 36" Max Trench Bottom Depth 36" Gravel Depth 12"


☑ New System ☐ Repair System Type: I, II, III, IV, V, VI
System Description: GRAVITY CONVENTIONAL
Repair System Description: PUMP SAME
Maintenance Agreement Required: ☐ Yes ☑ No

☑ House/Mod. Home No. Bedrooms 3
☐ Mobile Home No. Bathrooms 3
☐ Business No. Employees ____
☐ Other ____
☐ Slab ☐ Crawl Space ☐ Basement w/plumbing ☐ Basement wo/plumbing

Water Supply: ☒ Individual ☐ Public ☐ Community


Comments:/Conditions: 1"=50'

INITIAL SITE SKETCH

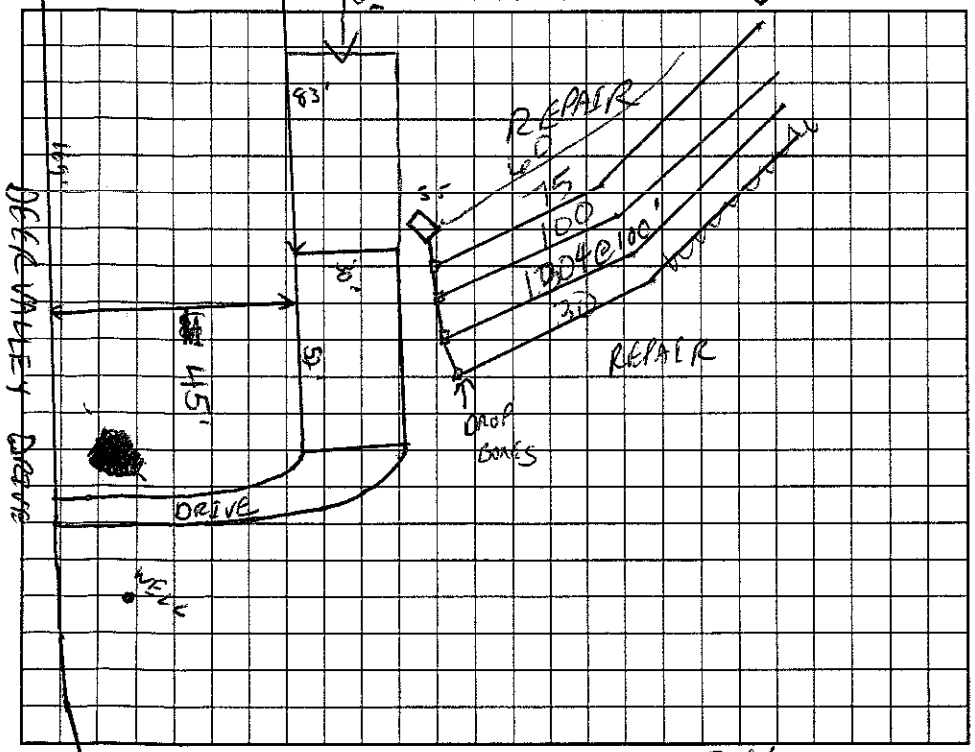

Comments:/Conditions: Polylock filter installed

AS BUILT SKETCH

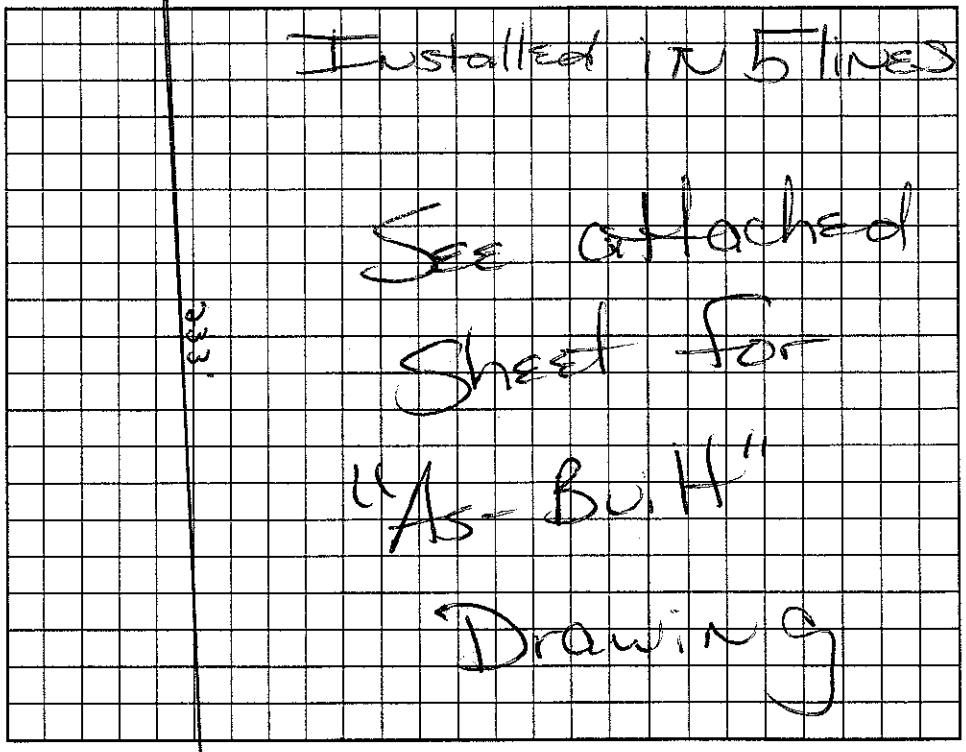

Permit can be suspended or revoked if any false information is supplied toward securing the permit/any unauthorized changes are made to the site/any unauthorized changes are made in the installation of the system. Improvement Permit with plat valid without expiration. Improvement Permit with site plan valid for sixty months. Authorization to Construct is valid for a period equal to that of Improvement Permit – not to exceed sixty months.

Signed: James E Mickwit date 8/3/00

Improvement Permit by: C. [illegible] RS date 8/2/00

Authorization to Construct by: C. [illegible] RS date 8/2/00

Installed by: A-1 Backhoe

Operation Permit by: [illegible] RS date 11/14/2000

Existing System Inspection by: ____ date ____

HEALTH DEPT. COPY: WHITE OWNER COPY (FINAL): YELLOW OWNER COPY (INITIAL): PINK