IREDELL COUNTY HEALTH DEPARTMENT

STATESVILLE 704-878-5305 MOORESVILLE 704-664-5281

IMPROVEMENT PERMIT / AUTHORIZATION TO CONSTRUCT / OPERATION PERMIT / EXISTING SYSTEM INSPECTION

PERMIT# 082702 PIN# 4761-65-1580 (pt) 4761-43-9106 DATE Dec 14 '99

OWNER OR CONTRACTOR Deer Valley Dev. Group LLC PHONE: Business 664-9080 Home

ADDRESS 255 Rolling Hills Rd. Mooresville

LOCATION 1115-21 N. TR Stewart-Amity Rd. TR Brawley Rd. on Right

SUBDIVISION Deer Valley BLOCK / SECTION LOT 14 LOT AREA .90 AC SITE CLASS. PS DESIGN FLOW 360gpd L.T.A.R. .3 ±

Septic Tank: 1000 Gallons; STB 1012 Date 1-2-2000
Pump Tank: 1000 Gallons; PT 17 Date 9-30-00
Pump Make: Hydromatic Model 5K5041 Serial No.
Nitrification Field: No. Fields 1 Square Feet 1200 Linear Feet 400
No. Lines 4@100' Trench Width 36" Max Trench Bottom Depth 36" Gravel Depth 12"

☑ New System ☐ Repair System Type: I, II, (III), IV, V, VI
System Description: PM - CONVENTIONAL
Repair System Description: PM - INNOVATIVE - 25% Red.
Maintenance Agreement Required: ☐ Yes ☐ No

☑ House/Mod. Home No. Bedrooms 3
☐ Mobile Home No. Bathrooms 2
☐ Business No. Employees
☐ Other


☐ Slab ☑ Crawl Space ☐ Basement w/plumbing ☐ Basement wo/plumbing

Water Supply: ☑ Individual ☐ Public ☐ Community


Comments:/Conditions:

Comments:/Conditions:

1"=50' INITIAL SITE SKETCH

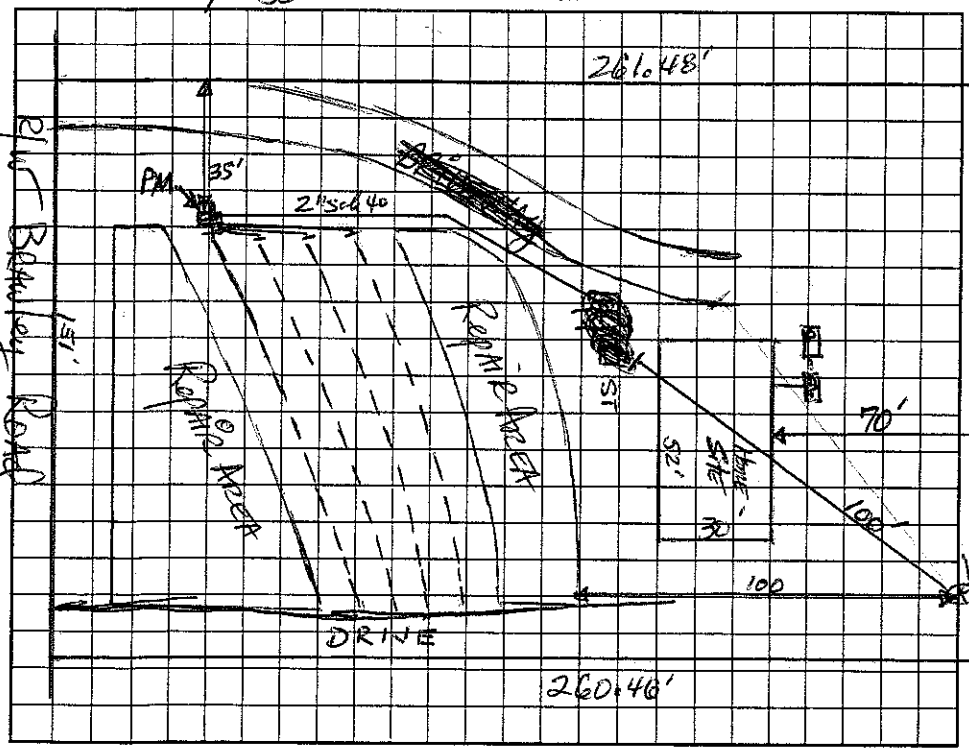

AS BUILT SKETCH

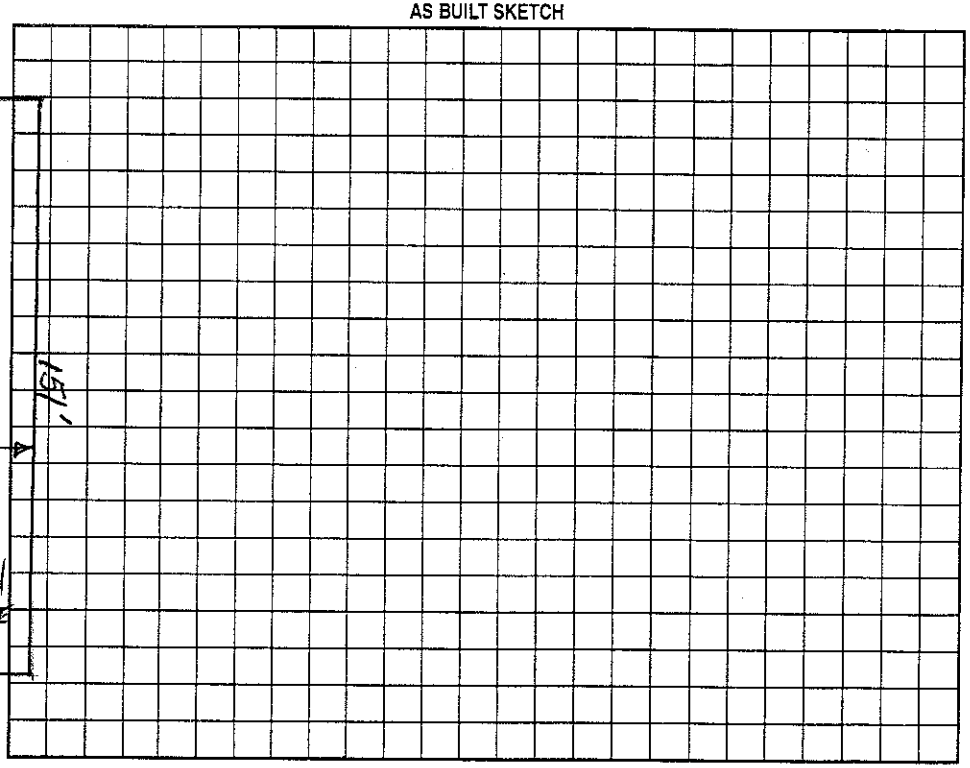

Permit can be suspended or revoked if any false information is supplied toward securing the permit/any unauthorized changes are made to the site/any unauthorized changes are made in the installation of the system. Improvement Permit with plat valid without expiration. Improvement Permit with site plan valid for sixty months. Authorization to Construct is valid for a period equal to that of Improvement Permit – not to exceed sixty months.

Signed: [signature] date 12/22/99

Improvement Permit by: [signature], RS date 12-14-99

Authorization to Construct by: [signature], RS date 12-14-99

Installed by: A-1 Backhoe

Operation Permit by: Wesley Sparks RS. date 4/18/01

Existing System Inspection by: date

HEALTH DEPT. COPY: WHITE OWNER COPY (FINAL): YELLOW OWNER COPY (INITIAL): PINK