IREDELL COUNTY HEALTH DEPARTMENT

STATESVILLE 704-878-5305 MOORESVILLE 704-664-5281

IMPROVEMENT PERMIT / AUTHORIZATION TO CONSTRUCT / OPERATION PERMIT / EXISTING SYSTEM INSPECTION

PERMIT# 082720 PIN# ~~4761-65-1580 (lot)~~ 4761-44-7862

OWNER OR CONTRACTOR Deer Valley Dev. Group LLC PHONE: Business 664-9080 DATE Dec. 8, '99

ADDRESS 255 Rolling Hills Rd. Mooresville Home

LOCATION 115-2 BIN. TR Ostwalt-Amity on Right before jct w/ Brawley Rd.

SUBDIVISION Deer Valley BLOCK / SECTION LOT 51 LOT AREA 1.14 ac SITE CLASS PSI DESIGN FLOW 360 gpd L.T.A.R. 3

Septic Tank: 1000 Gallons; STB 1512 Tp Date 5-14-00

Pump Tank: Gallons; PT Date

Pump Make: Model Serial No.

Nitrification Field: No Fields 1 Square Feet 1200 Linear Feet 400

No Lines 5@80' Trench Width 36" Max Trench Bottom Depth 36" Gravel Depth 12"

☑ New System ☐ Repair System Type: I, II, III, IV, V, VI

System Description: Gravity conventional

Repair System Description: same

Maintenance Agreement Required: ☐ Yes ☑ No

☑ House/Mod. Home No. Bedrooms 3

☐ Mobile Home No. Bathrooms 2

☐ Business No. Employees

☐ Other

☐ Slab ☑ Crawl Space ☐ Basement w/plumbing ☐ Basement wo/plumbing


Water Supply: ☑ Individual ☐ Public ☐ Community

Comments:/Conditions:

Adjusted Wells Site

Septic Tank Lines Set

INITIAL SITE SKETCH 1"=50'

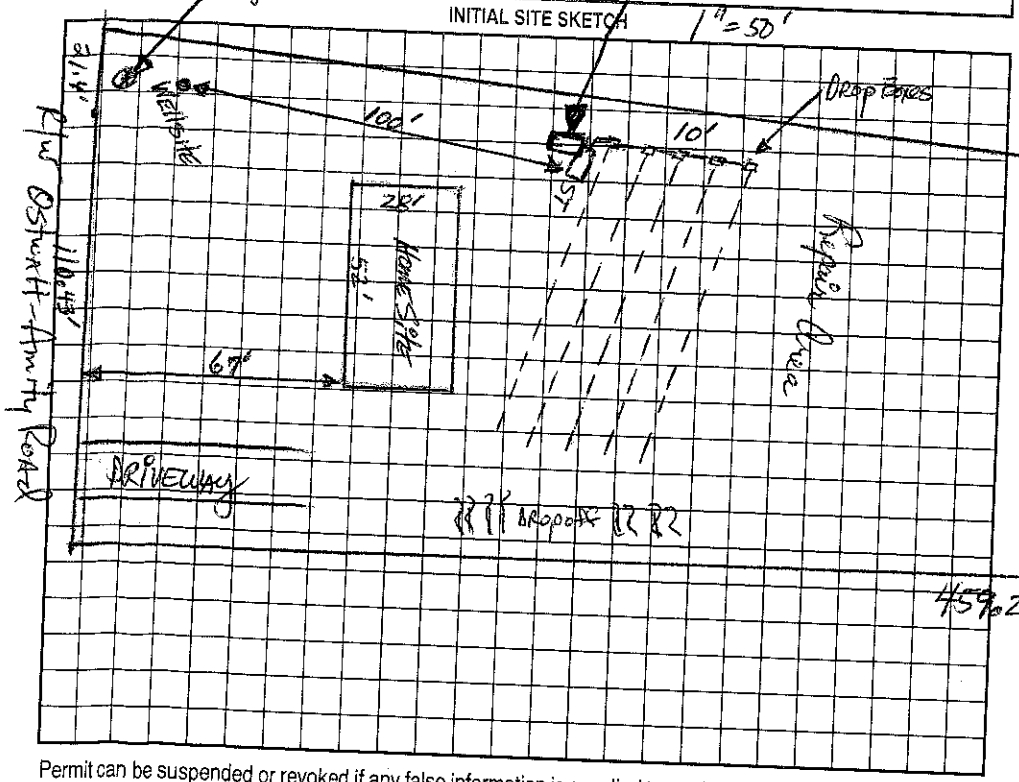


Comments:/Conditions:

Well not installed as of 10-18-00

Septic System installed substantially as shown.

AS BUILT SKETCH

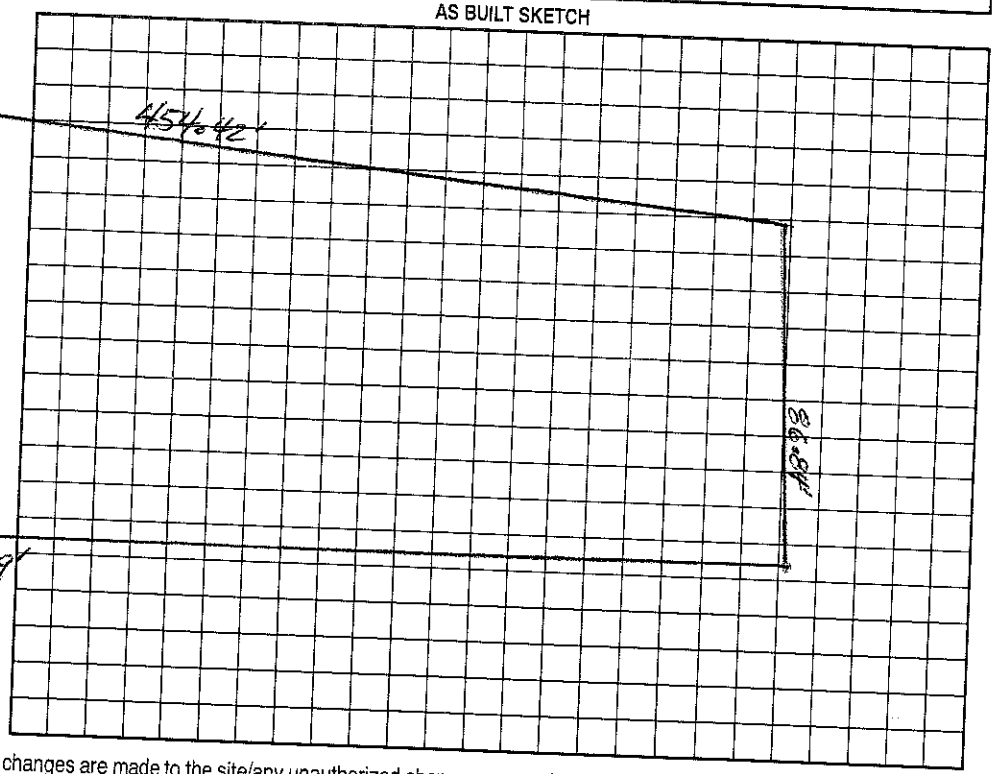

Permit can be suspended or revoked if any false information is supplied toward securing the permit/any unauthorized changes are made to the site/any unauthorized changes are made in the installation of the system. Improvement Permit with plat valid without expiration. Improvement Permit with site plan valid for sixty months. Authorization to Construct is valid for a period equal to that of Improvement Permit – not to exceed sixty months.

Signed: Jane E Mills

Improvement Permit by: Mark Huffman, RS date 12/8/99

Authorization to Construct by: Mark Huffman, RS date 12-8-99

Installed by: A-1 Backhoe

Operation Permit by: D Huffman, RS date 10-18-00

Existing System Inspection by: date

HEALTH DEPT. COPY: WHITE OWNER COPY (FINAL): YELLOW OWNER COPY (INITIAL): PINK