A1 Backhoe 1:00 - 1:30

IREDELL COUNTY HEALTH DEPARTMENT

STATESVILLE 704-878-5305 MOORESVILLE 704-664-5281

IMPROVEMENT PERMIT / AUTHORIZATION TO CONSTRUCT / OPERATION PERMIT / EXISTING SYSTEM INSPECTION

PERMIT# 082719 PIN# ~~4761-65-1580 (pt)~~ 4761-44-8766 DATE October 29, '99

OWNER OR CONTRACTOR Deer Valley Dev. LLC PHONE: Business 664-9080 Home

ADDRESS 255 Rolling Hills Rd. Mooresville

LOCATION I-15-2 N. TR1001 Ostwalt Amity Rd. on Right just before pvt w/ Brawley Rd.

SUBDIVISION Deer Valley BLOCK / SECTION LOT 50 LOT AREA 1.22 Ac SITE CLASS. PS DESIGN FLOW 360 gpd L.T.A.R. .03

Septic Tank: Gallons; STB 1017 Date 7/16/99
Pump Tank: Gallons; PT Date
Pump Make: Model Serial No.
Nitrification Field: No Fields 1 Square Feet 1200 Linear Feet 400
No Lines 4 @ 100' Trench Width 36" Max Trench Bottom Depth 36" Gravel Depth 12"

☑ New System ☐ Repair System Type: I, II, III, IV, V, VI
System Description: Gravity Conventional
Repair System Description: Same
Maintenance Agreement Required: ☐ Yes ☑ No

☑ House/Mod. Home No. Bedrooms 3
☐ Mobile Home No. Bathrooms 2
☐ Business No. Employees
☐ Other

☐ Slab ☑ Crawl Space ☐ Basement w/plumbing ☐ Basement wo/plumbing


Water Supply: ☑ Individual ☐ Public ☐ Community

Comments:/Conditions: Maintain 100' minimum separation between Septic system & well


Comments:/Conditions:

1" = 60'

INITIAL SITE SKETCH

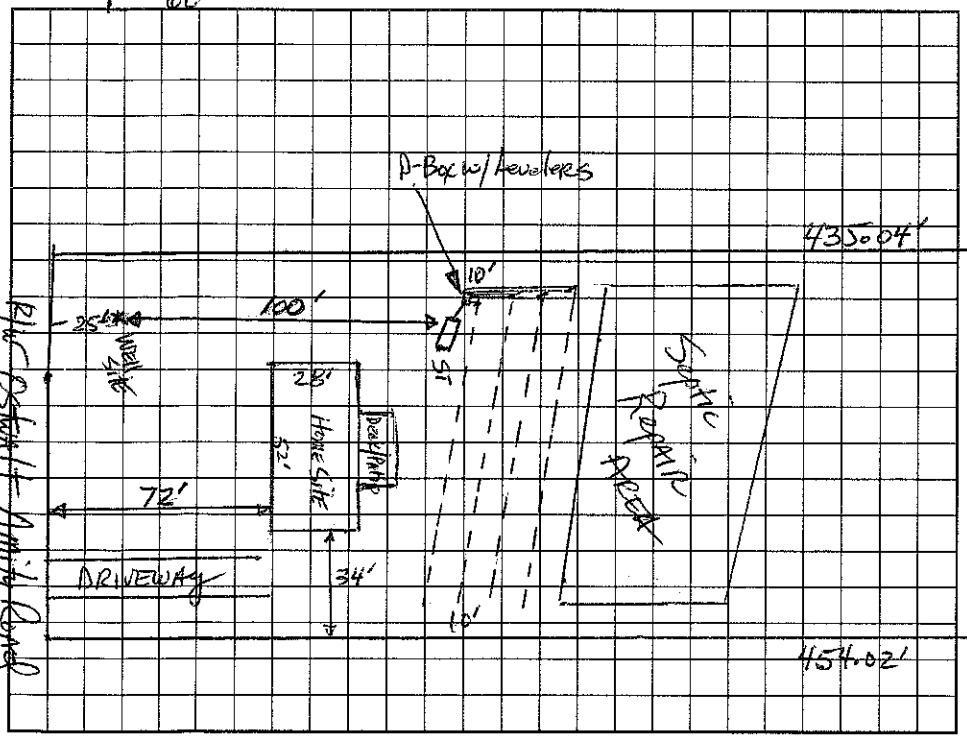

AS BUILT SKETCH

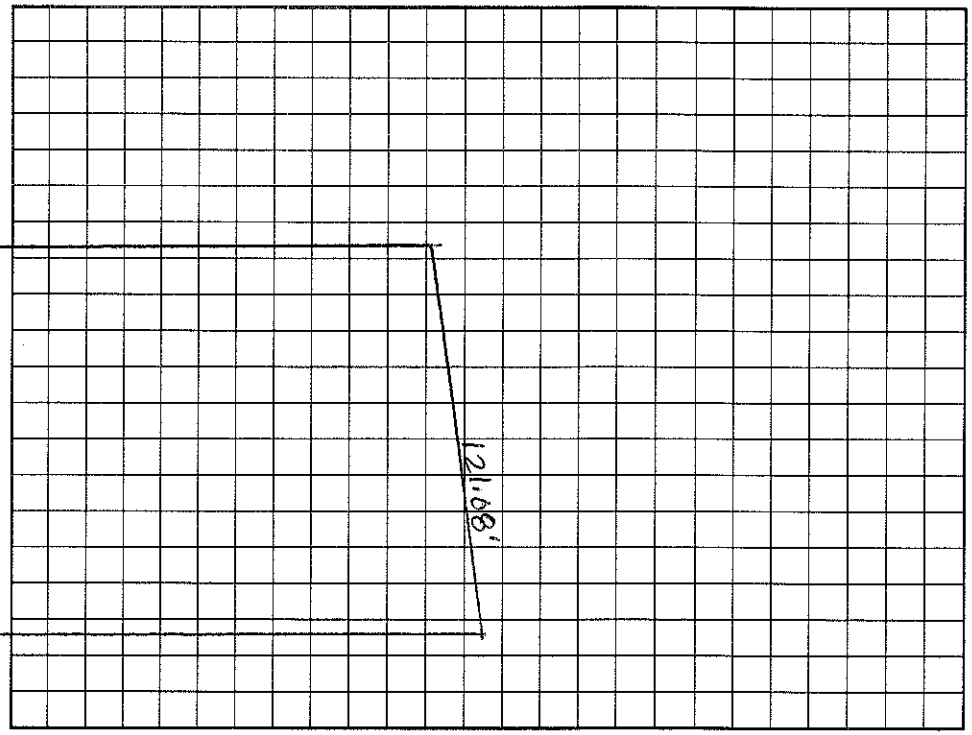

Permit can be suspended or revoked if any false information is supplied toward securing the permit/any unauthorized changes are made to the site/any unauthorized changes are made in the installation of the system. Improvement Permit with plat valid without expiration. Improvement Permit with site plan valid for sixty months. Authorization to Construct is valid for a period equal to that of Improvement Permit – not to exceed sixty months.

Signed: date

Installed by: A-1 Backhoe

Improvement Permit by: Mark R. Thomas, RS date 10-29-99

Operation Permit by: Wesley Sparks R.S. date 11/16/99

Authorization to Construct by: Mark R. Thomas, RS date 10-29-99

Existing System Inspection by: date

HEALTH DEPT. COPY: WHITE OWNER COPY (FINAL): YELLOW OWNER COPY (INITIAL): PINK