3:00

IREDELL COUNTY HEALTH DEPARTMENT

S...ESVILLE 704-878-5305 MOORESVILLE 704-664-5281

IMPROVEMENT PERMIT / AUTHORIZATION TO CONSTRUCT / OPERATION PERMIT / EXISTING SYSTEM INSPECTION

PERMIT# 082218 PIN# ~~4761-65-1580 Off~~ 4761-44-9761 DATE Dec. 8, '99

OWNER OR CONTRACTOR Deer Valley Dev. Group LLC PHONE: Business 664-9080 Home

ADDRESS 255 Rolling Hills Rd Mooresville

LOCATION 115-21 No. TR Ostwalt-Amity Rd. On Right before jct w/ Brawley Rd.

SUBDIVISION Deer Valley BLOCK / SECTION LOT 49 LOT AREA 1.17 SITE CLASS. PS DESIGN FLOW 360gpd L.T.A.R. .25

Septic Tank: 1000 Gallons; STB 317 Date 4/4/00

Pump Tank: Gallons; PT Date

Pump Make: Model Serial No.

Nitrification Field: No Fields 1 Square Feet 1440 Linear Feet 480

No Lines 5@96' Trench Width 36" Trench Bottom Depth 36" Gravel Depth 12"

☑ New System ☐ Repair System Type: I, II, III, IV, V, VI

System Description: Gravity Conventional

Repair System Description: Same

Maintenance Agreement Required: ☐ Yes ☑ No

☑ House/Mod. Home No. Bedrooms 3

☐ Mobile Home No. Bathrooms 2

☐ Business No. Employees

☐ Other

☐ Slab ☑ Crawl Space ☐ Basement w/plumbing ☐ Basement wo/plumbing

Water Supply: ☑ Individual ☐ Public ☐ Community


Comments:/Conditions: Install trenches at 36" trench bottom depth.

* NO TEE INSTALLED *


Comments:/Conditions: Tanks checked 4 Lines checked

1" = 50'

INITIAL SITE SKETCH

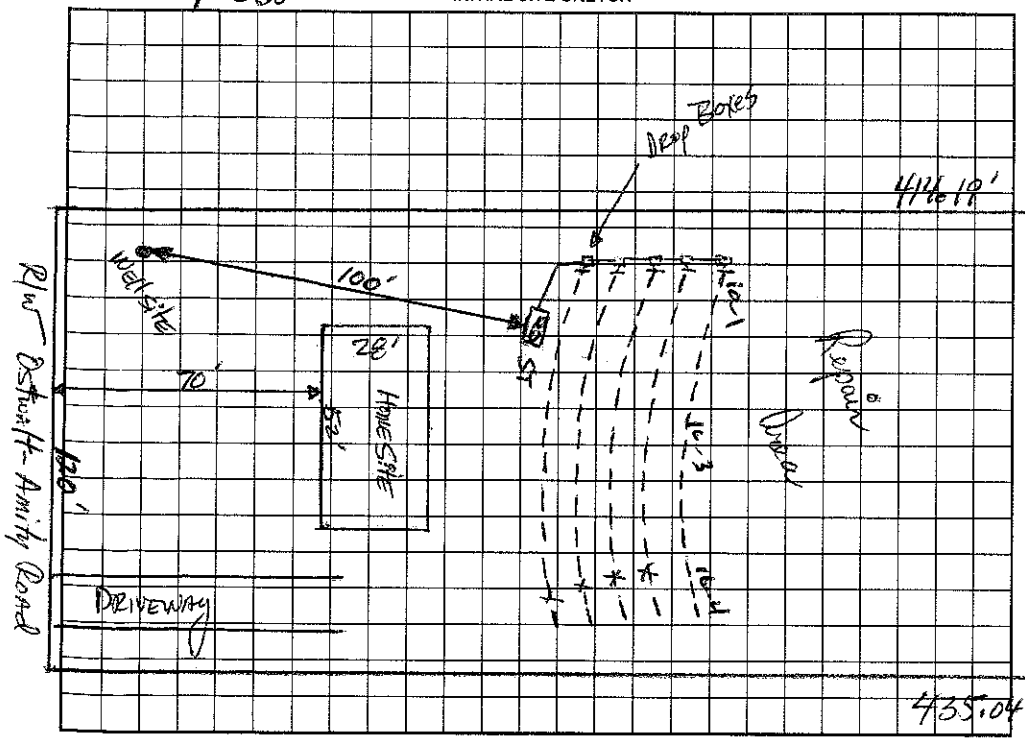

AS BUILT SKETCH

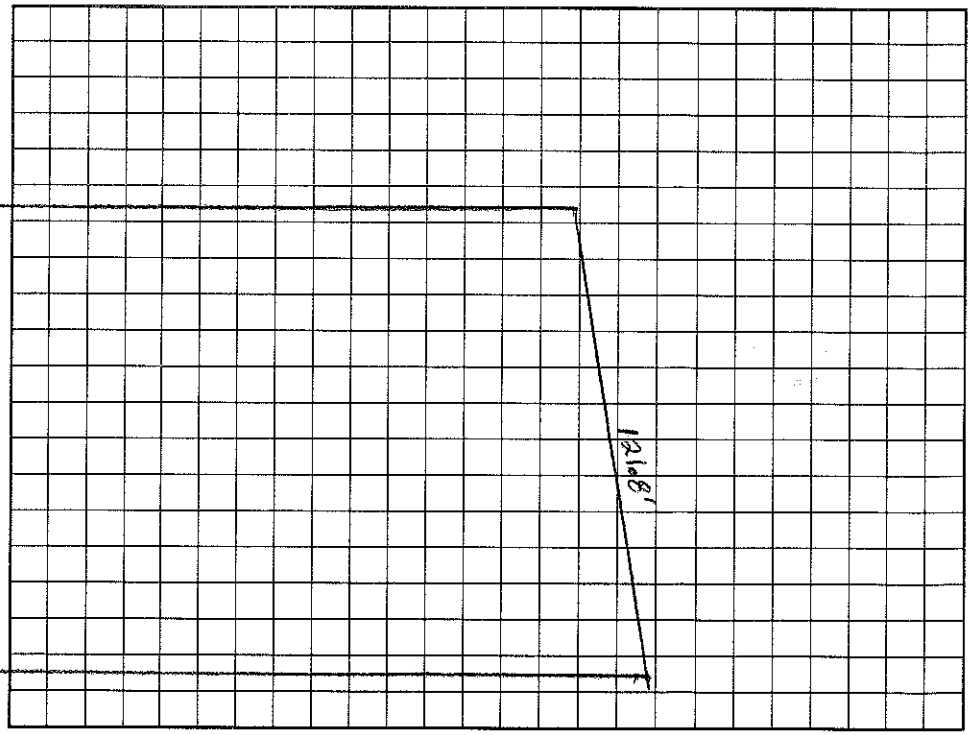

Permit can be suspended or revoked if any false information is supplied toward securing the permit/any unauthorized changes are made to the site/any unauthorized changes are made in the installation of the system. Improvement Permit with plat valid without expiration. Improvement Permit with site plan valid for sixty months. Authorization to Construct is valid for a period equal to that of Improvement Permit – not to exceed sixty months.

Signed: Janice E McKnight date 12/8/99

Improvement Permit by: Mark R. Hamm, RS date 12-8-99

Authorization to Construct by: Mark R. Hamm, RS date 12-8-99

Installed by: Tuckers Grading Service

Operation Permit by: Wesley Sparks RS. date 6/19/00

Existing System Inspection by: date

HEALTH DEPT. COPY: WHITE OWNER COPY (FINAL): YELLOW OWNER COPY (INITIAL): PINK