IREDELL COUNTY HEALTH DEPARTMENT

Statesville Office (704) 878-5305 Mooresville Office (704) 660-3625

ISA

4761 45 6467

PERMIT # 219855

IMPROVEMENT PERMIT / AUTHORIZATION TO CONSTRUCT / OPERATION PERMIT / EXISTING SYSTEM

PIN # ~~4761358542~~

APPLICANT: David Calary APPLICANT ADDRESS: 725 Eden Dr Southport, NC 28461

SITE ADDRESS: 1097 Ostwalt Amity Rd Statesville, NC 28677 PHONE: 910619-0187 ALT. PHONE:

SITE DIRECTIONS: Ostwalt Amity Rd @ intersection with Bethesda Rd on right

SUBDIVISION: — SECTION: — LOT # — LOT AREA: 5.794 Ac DESIGN FLOW: 240gpd L.T.A.R.: .25

Septic Tank	1000	(gal)	STB		Date		☒ New System	☐ Repair	☐ Expansion	System Type: I (II) III IV V VI	
Pump Tank		(gal)	PT		Date		System Description:	Gravity – Conventional			
Pump Make			Model		Serial #		Repair System Description:	Same			
# Nitrification Fields	1		# Lines	4	Linear Ft:	320ft	Maintenance Agreement Required:	☐ YES	☒ NO		
Trench Width	36"		Max. Trench Bottom Depth		Gravel Depth	12"	☒ GRAVITY	☐ PRESSURE			


☒ Residence No. Bedrooms 2 — ☐ Business No. Persons — ☐ Other No. Employees — ☐ Slab ☒ Crawl Space — ☐ Basement w/ plumbing ☐ Basement w/o plumbing

Water Supply: ☒ Private ☐ Public ☐ Community


Comments / Conditions: * Must divert Stormwater/surface water away from Septic System

Note: Bathroom in "Shop" and "Woman's Cave" will also feed into Septic System

INITIAL SITE SKETCH

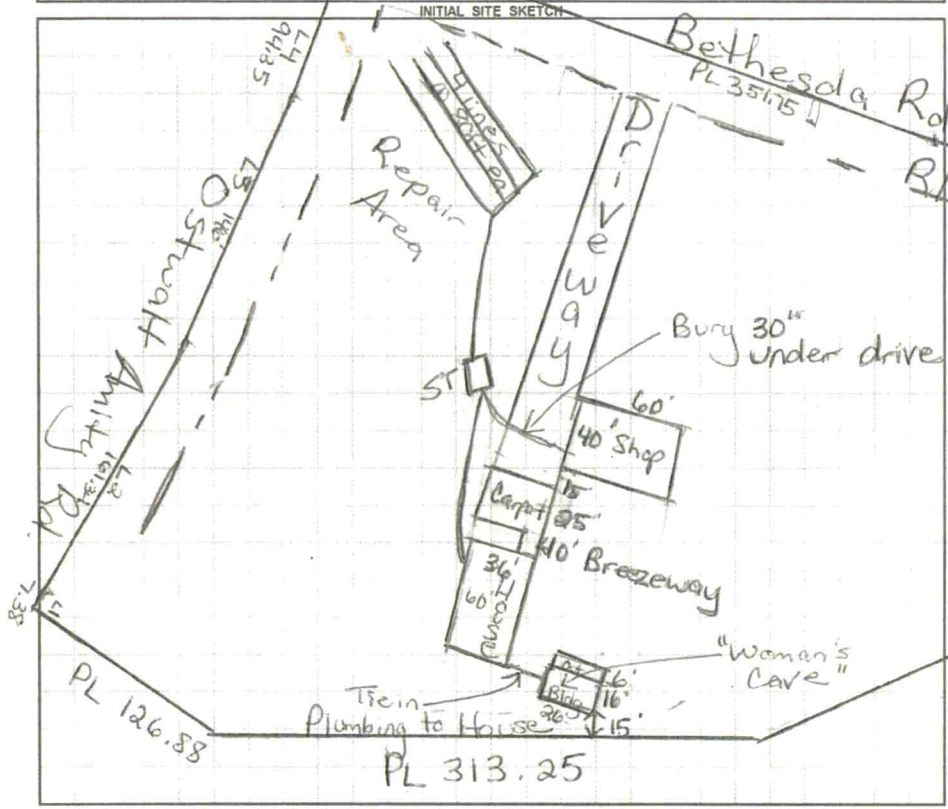

AS BUILT SKETCH

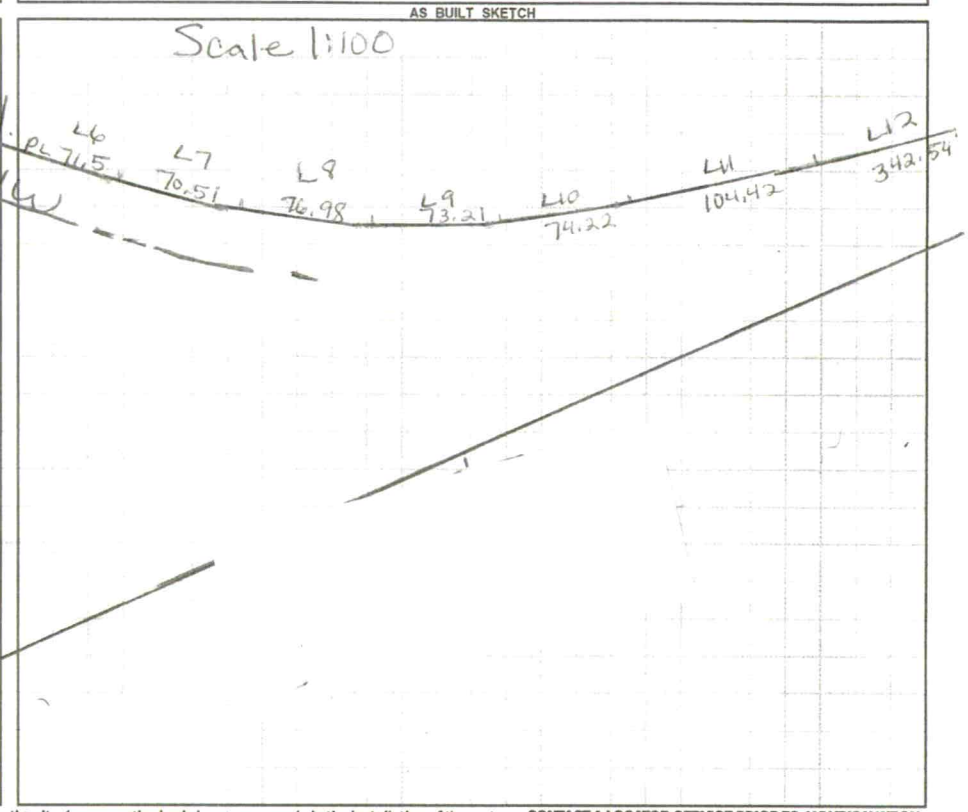

Permit can be suspended or revoked if any false information is supplied toward securing the permit / any unauthorized changes are made to the site / any unauthorized changes are made in the installation of the system. **CONTACT A LOCATOR SERVICE PRIOR TO ANY EXCAVATION**

☐ **IMPROVEMENT PERMIT** *with plat* valid without expiration. ☐ **IMPROVEMENT PERMIT** *with site plan* valid for 60 mos. ☒ **AUTHORIZATION TO CONSTRUCT** valid for period equal to IMPROVEMENT PERMIT--not to exceed 60 mo.

Owner / Applicant Signature: David Calary Date: 2/17/17 Installed by: Abernethy Grading + Septic

IMPROVEMENT PERMIT by: Maria Dotson RS Date: 1/9/17 OPERATION PERMIT by: ICHD Date: End of 2017

AUTHORIZATION TO CONSTRUCT by: Maria Dotson RS Date: 1/9/17 Existing System Inspected by: Date:

Health Dept. Copy - WHITE Applicant (Final Approval) - YELLOW Applicant (Conditional Approval) - PINK