RA

IREDELL COUNTY HEALTH DEPARTMENT

Statesville Office (704) 878-5305 Mooresville Office (704) 660-3625 PERMIT # 220851

IMPROVEMENT PERMIT / AUTHORIZATION TO CONSTRUCT / OPERATION PERMIT / EXISTING SYSTEM

PIN # 4761-49-6795

APPLICANT: Michael Ryan Homes Inc. APPLICANT ADDRESS: 10400 Mallard Creek Rd Ste 102 charlotte, NC 28262

SITE ADDRESS: 128 Wylie Trail Statesville, NC 28677 PHONE: 704-202-5791 ALT. PHONE:

SITE DIRECTIONS: Rt 21 North → R on Oswolf Amity Rd → Left on Bethlehem Rd → R on Northlake Dr → L on Mountain Island → Rn on Wylie

SUBDIVISION: Northlake SECTION: 2 LOT # 35 LOT AREA: 0.68 acres DESIGN FLOW: 480 GPD L.T.A.R.: 0.30

Septic Tank	1000	(gal)	STB	794	Date	Permit	☒ New System	☐ Repair	☐ Expansion	System Type: I II ⓘ IV V VI	☒ Residence	No. Bedrooms	4	Water Supply
Pump Tank	—	(gal)	PT	—	Date	—	System Description:	25% Reduction			☐ Business	No. Persons	8	☐ Private
Pump Make	—	Model	—		Serial #	—	Repair System Description:	25% Reduction			☐ Other	No. Employees	—	☒ Public
# Nitrification Fields	1	# Lines	5		Linear Ft:	400	Maintenance Agreement Required:	☐ YES	☒ NO		☒ Slab	☐ Crawl Space		☐ Community
Trench Width	36"	Max. Trench Bottom Depth	32" (low side)		Gravel Depth	—		☒ GRAVITY	☐ PRESSURE		☐ Basement w/plumbing		☐ Basement w/o plumbing	

Comments / Conditions: Follow all N.C. septic rules. Recommend pumping septic tank every 3-5 years.

INITIAL SITE SKETCH

See attached plans from Adrian Prueft LSS # 1314 Dated 7-31-2016

AS BUILT SKETCH

Permit can be suspended or revoked if any false information is supplied toward securing the permit / any unauthorized changes are made to the site / any unauthorized changes are made in the installation of the system. **CONTACT A LOCATOR SERVICE PRIOR TO ANY EXCAVATION**


☐ **IMPROVEMENT PERMIT** *with plat valid without expiration.* ☒ **IMPROVEMENT PERMIT** *with site plan valid for 60 mos.* ☒ **AUTHORIZATION TO CONSTRUCT** *valid for period equal to IMPROVEMENT PERMIT--not to exceed 60 mo.*

Owner / Applicant Signature: [signature] Date: 8-12-16 Installed by: Marty Tucker

IMPROVEMENT PERMIT by: Tom Shuck Date: 8-12-16 OPERATION PERMIT by: [signature] Date: 11/22/16

AUTHORIZATION TO CONSTRUCT by: Tom Shuck Date: 8-12-16 Existing System Inspected by: Date:

Health Dept. Copy - WHITE Applicant (Final Approval) - YELLOW Applicant (Conditional Approval) - PINK

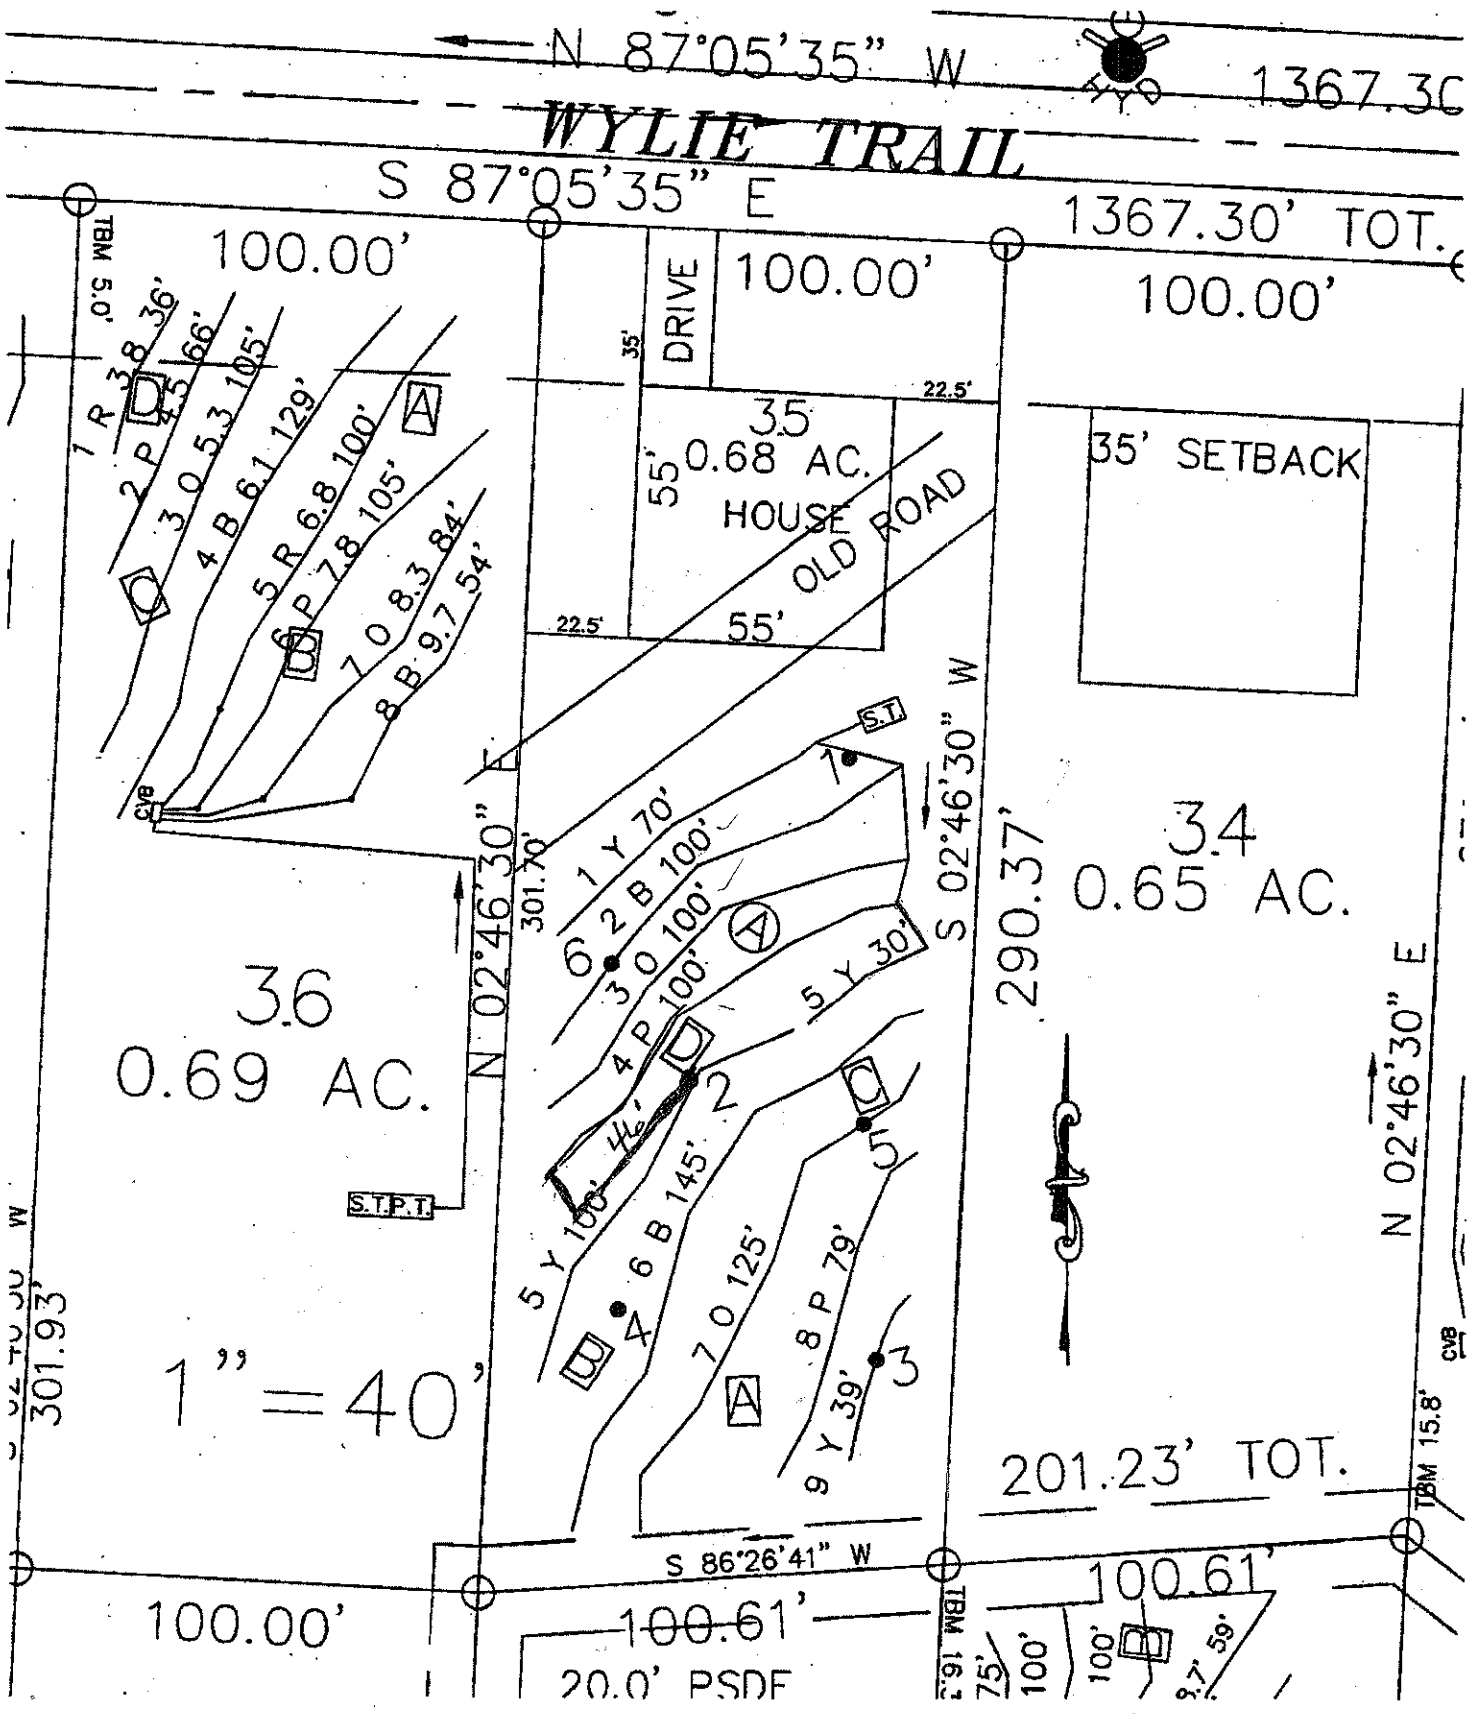

APPROVED AUG 12 2016