IREDELL COUNTY HEALTH DEPARTMENT

STATESVILLE 704-878-5305 MOORESVILLE 704-664-5281

IMPROVEMENT PERMIT / AUTHORIZATION TO CONSTRUCT / OPERATION PERMIT / EXISTING SYSTEM INSPECTION

PERMIT# 139469 PIN# ~~4761-50-6023~~ 4761-50-6094 DATE 12/8/06

OWNER OR APPLICANT REA MOR PROPERTIES/BRIAN STEPANEK PHONE: Business 663-4050 Home

ADDRESS 109C WILLIAMSON RD.

LOCATION 115N TR Shinnville Rd. To Brawley Rd. (R) Fairhaven Lot on (L)

SUBDIVISION FAIRHAVEN BLOCK / SECTION LOT 6A LOT AREA 6.945 AC SITE CLASS. PS DESIGN FLOW 600 L.T.A.R. .3

Septic Tank: 1500 Gallons; STB 32 Date 10/13/06

Pump Tank: Gallons; PT Date

Pump Make: Model Serial No.

Nitrification Field: No Fields 6 Square Feet 1500 Linear Feet 500

No Lines 5@100 Trench Width 3' Max Trench Bottom Depth 3' Gravel Depth

☒ New System ☐ Repair ☐ Expansion System Type: I II (III) IV V VI

System Description: GRAV - 25% RED.

Repair System Description: PRES - 16" PPBPS

Maintenance Agreement Required: ☐ Yes ☒ No

☒ Gravity ☐ Pressure

☒ House/Mod. Home ☐ Mobile Home ☐ Business ☐ Other

No. Bedrooms 5 No. Persons No. Employees


Water Supply: ☒ Individual ☐ Public ☐ Community

☐ Slab ☒ Crawl Space ☐ Basement w/plumbing ☐ Basement wo/plumbing


Comments/Conditions:

Comments/Conditions:

INITIAL SITE SKETCH

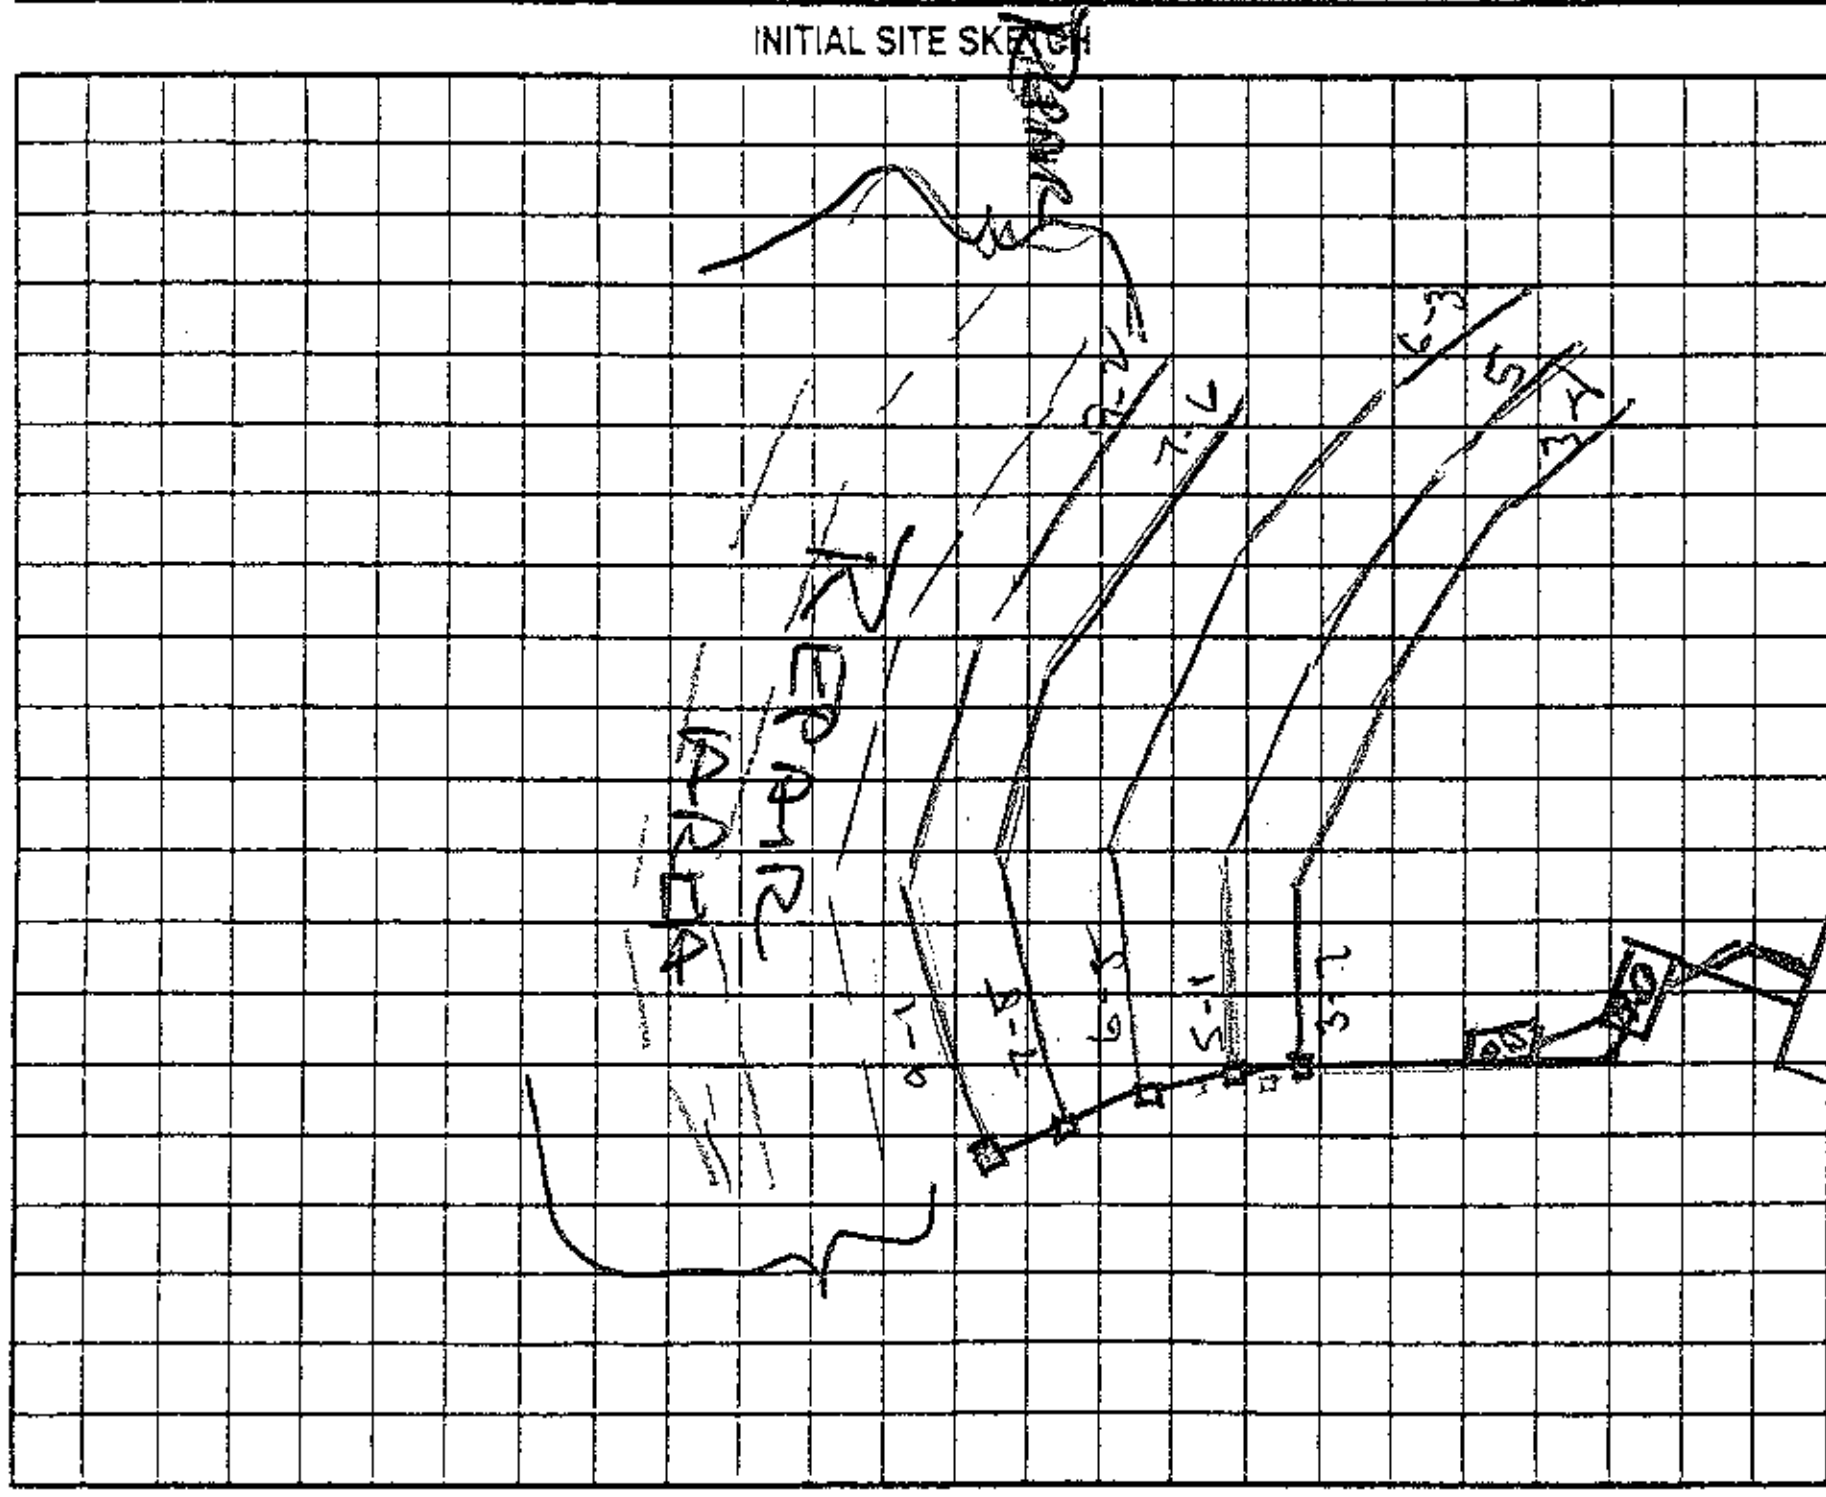

AS BUILT SKETCH

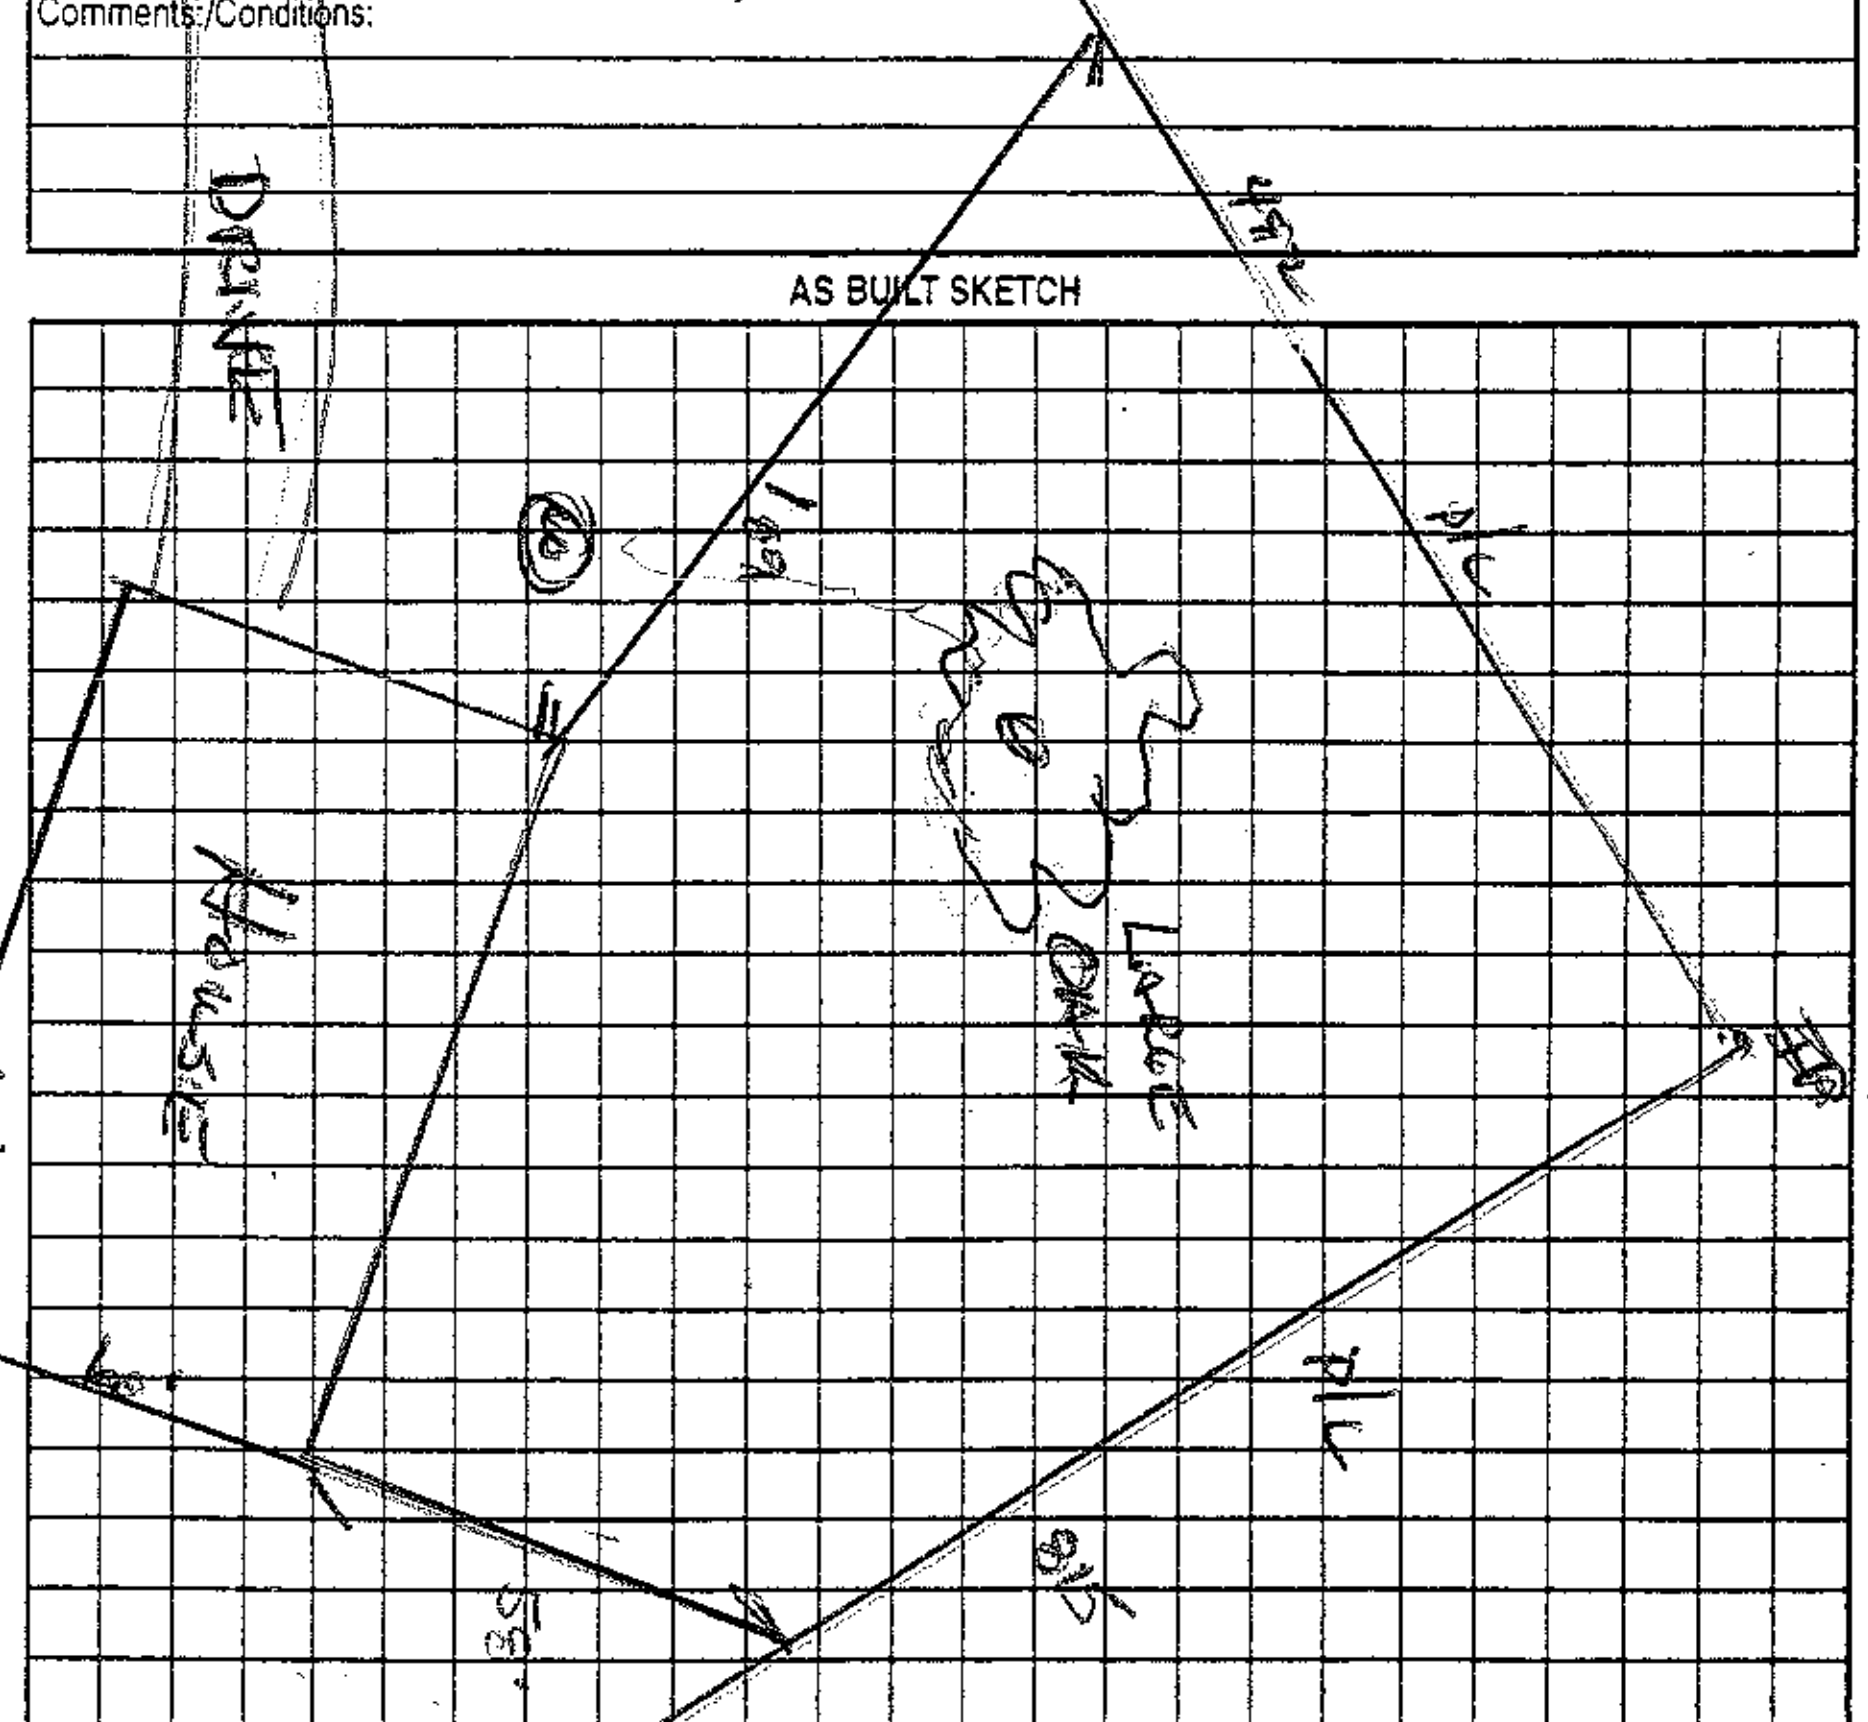

Permit can be suspended or revoked if any false information is supplied toward securing the permit/any unauthorized changes are made to the site/any unauthorized changes are made in the installation of the system. Improvement Permit with plat valid without expiration ☐ Improvement Permit with site plan valid for sixty months ☐ Authorization to Construct is valid for a period equal to that of Improvement Permit – not to exceed sixty months.

Signed: [signature] date 12/8/06

Improvement Permit by: Wesley Sparks RS date 12/8/06

Authorization to Construct by: Wesley Sparks RS date 1/18/07

Installed by: Dennis Willis

Operation Permit by: Wesley Sparks RS. date 5/15/07

Existing System Inspection by: date

HEALTH DEPT. COPY: WHITE OWNER COPY (FINAL): YELLOW OWNER COPY (INITIAL): PINK