IREDELL COUNTY HEALTH DEPARTMENT

STATESVILLE 704-878-5305 MOORESVILLE 704-664-5281

IMPROVEMENT PERMIT / AUTHORIZATION TO CONSTRUCT / OPERATION PERMIT / EXISTING SYSTEM INSPECTION

PERMIT# 120531 PIN# 4761-52-6919 DATE 1/13/05

OWNER OR CONTRACTOR Chris Stacy PHONE: Business 704-516-2677 Home

ADDRESS 965 Shearer Rd Mooresville NC 28115

LOCATION 115N, TR Shinnville, TL Brawley, on Rt Near End

SUBDIVISION BLOCK / SECTION LOT LOT AREA 14.19Ac SITE CLASS. PS DESIGN FLOW 360 L.T.A.R. 0.3

Septic Tank: 1000 Gallons; STB 794 Date 9/4/04
Pump Tank: Gallons; PT Date
Pump Make: Model Serial No.
Nitrification Field: No Fields 1 Square Feet 1200 Linear Feet 400
No Lines 5 @ 80' Trench Width 36" Max Trench Bottom Depth 36" Gravel Depth 12"

☒ New System ☐ Repair System Type: I (II) III, IV, V, VI
System Description: Gravity Conventional
Repair System Description: Same
Maintenance Agreement Required: ☐ Yes ☒ No

☒ House/Mod. Home No. Bedrooms 3
☐ Mobile Home No. Bathrooms
☐ Business No. Employees
☐ Other


☐ Slab ☐ Crawl Space ☒ Basement w/plumbing ☐ Basement wo/plumbing

Water Supply: ☒ Individual ☐ Public ☐ Community


Comments:/Conditions:

Comments:/Conditions:

INITIAL SITE SKETCH

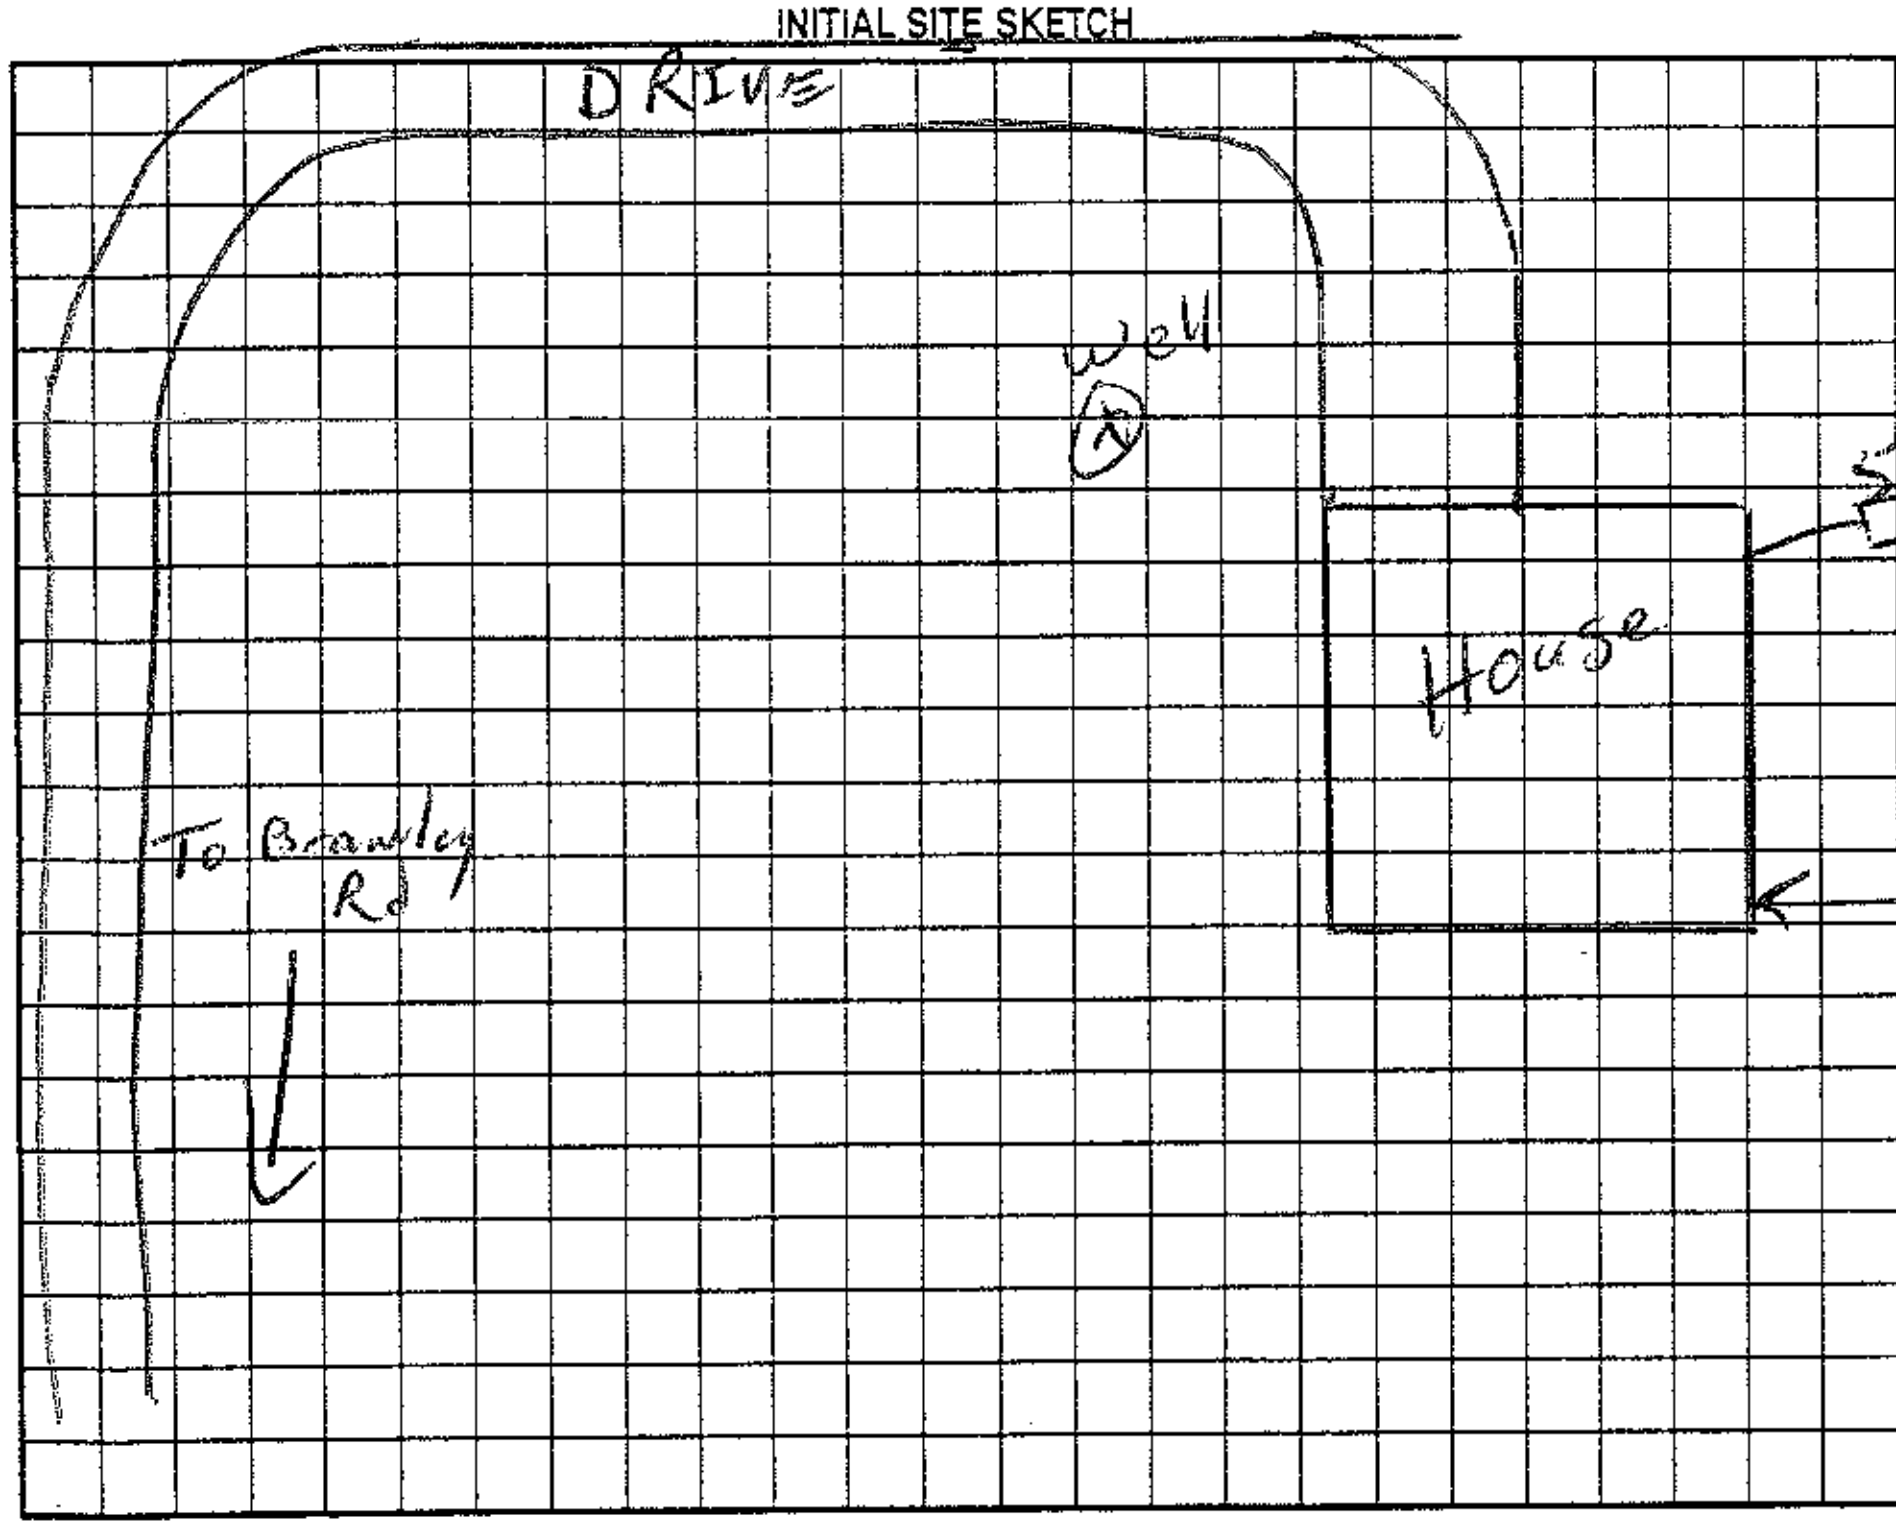

AS BUILT SKETCH

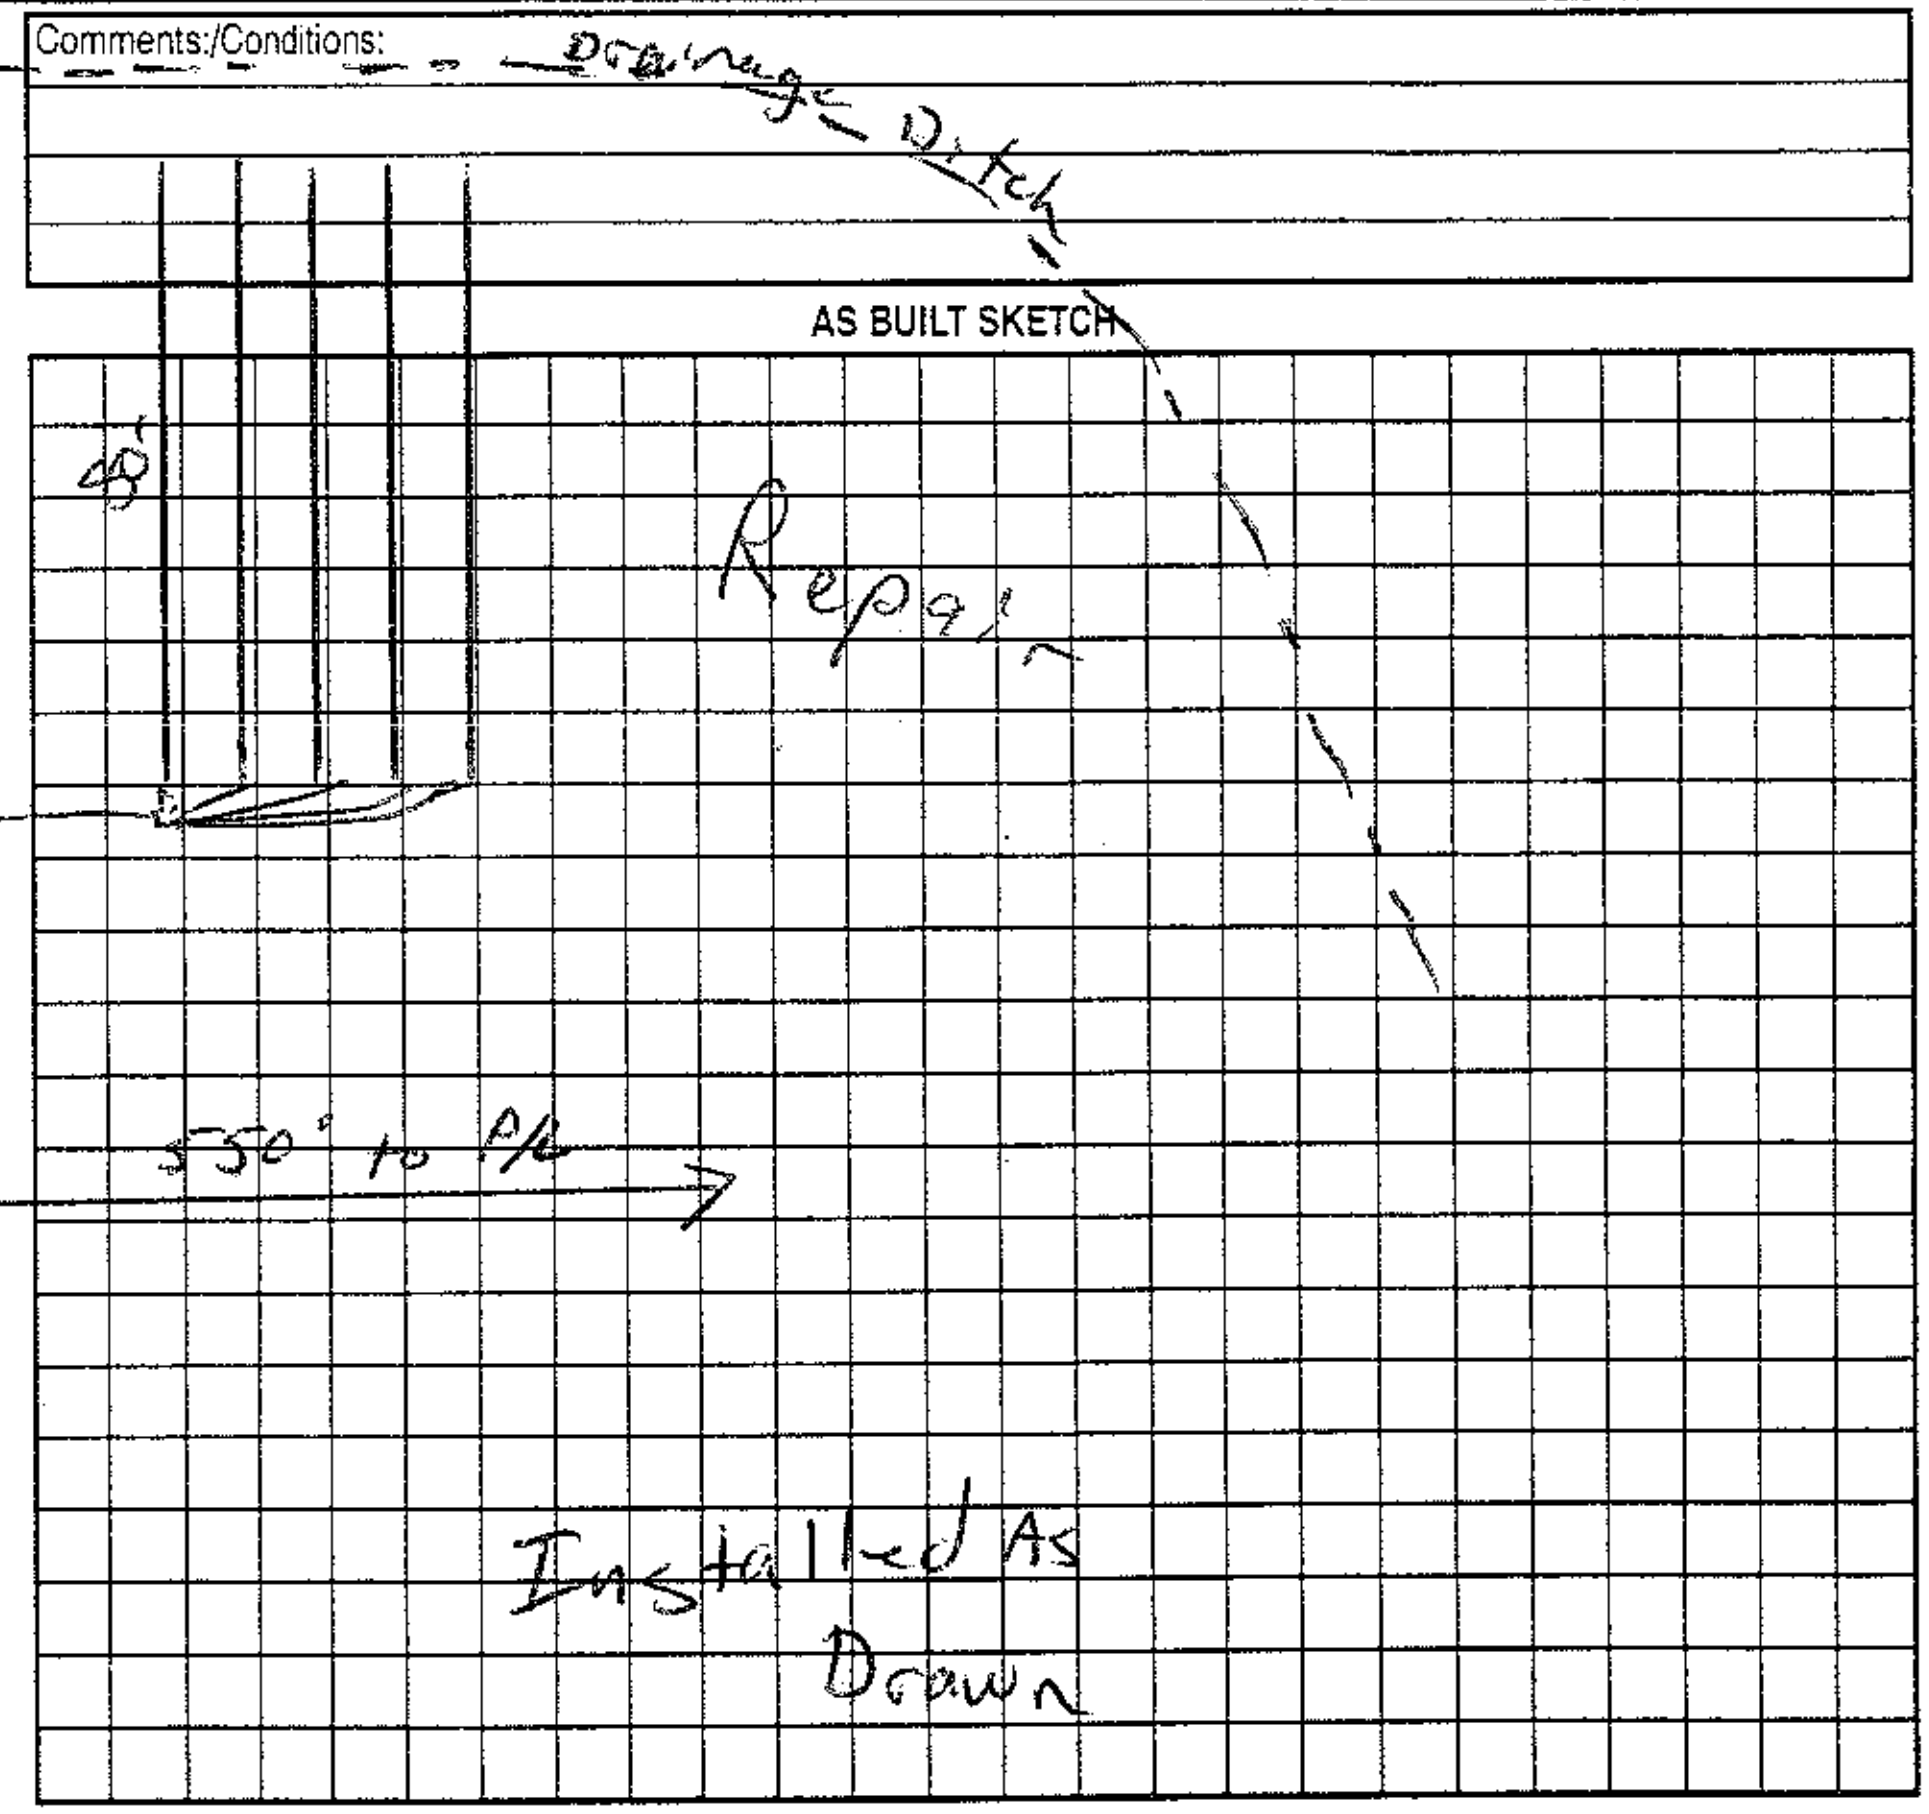

Permit can be suspended or revoked if any false information is supplied toward securing the permit/any unauthorized changes are made to the site/any unauthorized changes are made in the installation of the system. Improvement Permit with plat valid without expiration. Improvement Permit with site plan valid for sixty months. Authorization to Construct is valid for a period equal to that of Improvement Permit – not to exceed sixty months.

Signed: Kari Stacy date 1/21/05 Installed by: Larry Bean

Improvement Permit by: [signature] RS date 1/13/05 Operation Permit by: [signature] RS date 2/17/05

Authorization to Construct by: [signature] RS date 1/13/05 Existing System Inspection by: date

HEALTH DEPT. COPY: WHITE OWNER COPY (FINAL): YELLOW OWNER COPY (INITIAL): PINK