IREDELL COUNTY HEALTH DEPARTMENT

STATESVILLE 704-878-5305 MOORESVILLE 704-664-5281

IMPROVEMENT PERMIT / AUTHORIZATION TO CONSTRUCT / OPERATION PERMIT / EXISTING SYSTEM INSPECTION

PERMIT# 082709 PIN# 4761-65-1580 (pt) 4761 53 0448 DATE Dec 14, '99

OWNER OR CONTRACTOR Deer Valley Dev. Group LLC PHONE: Business 664-9080 Home

ADDRESS 255 Rolling Hills Rd. Mooresville

LOCATION 115-21 N. TR Ostwalt-Amity Rd. TR Brawley Rd on Right 430 AWS

SUBDIVISION Deer Valley BLOCK / SECTION LOT 21 LOT AREA .91Ac SITE CLASS: PS DESIGN FLOW 360gpd L.T.A.R. .25-.3

Septic Tank: 1000 Gallons; STB Date

Pump Tank: 1000 Gallons; PT Date

Pump Make: Model 1380 AWS Serial No. 460 AWS

Nitrification Field: No Fields 1 Square Feet 990 Linear Feet 330

No Lines 8 4 AWS Trench Width 36" Max Trench Bottom Depth 36"

☑ New System ☐ Repair System Type: I, II, III, IV, V, VI

System Description: PM- INNOVATIVE - 25% Red.

Repair System Description: SAME

Maintenance Agreement Required: ☐ Yes ☑ No

Gravel Depth NA

☑ House/Mod. Home No. Bedrooms 3

☐ Mobile Home No. Bathrooms 2

☐ Business No. Employees

☐ Other


☐ Slab ☑ Crawl Space ☐ Basement w/plumbing ☐ Basement wo/plumbing

Water Supply: ☐ Individual ☐ Public ☐ Community

Comments:/Conditions: * ONE INSPECTION PORT PER LATERAL.

Comments:/Conditions: 2/29 - Changed to 430. home, 460 feet of Innovative Drainline - AWS

INITIAL SITE SKETCH

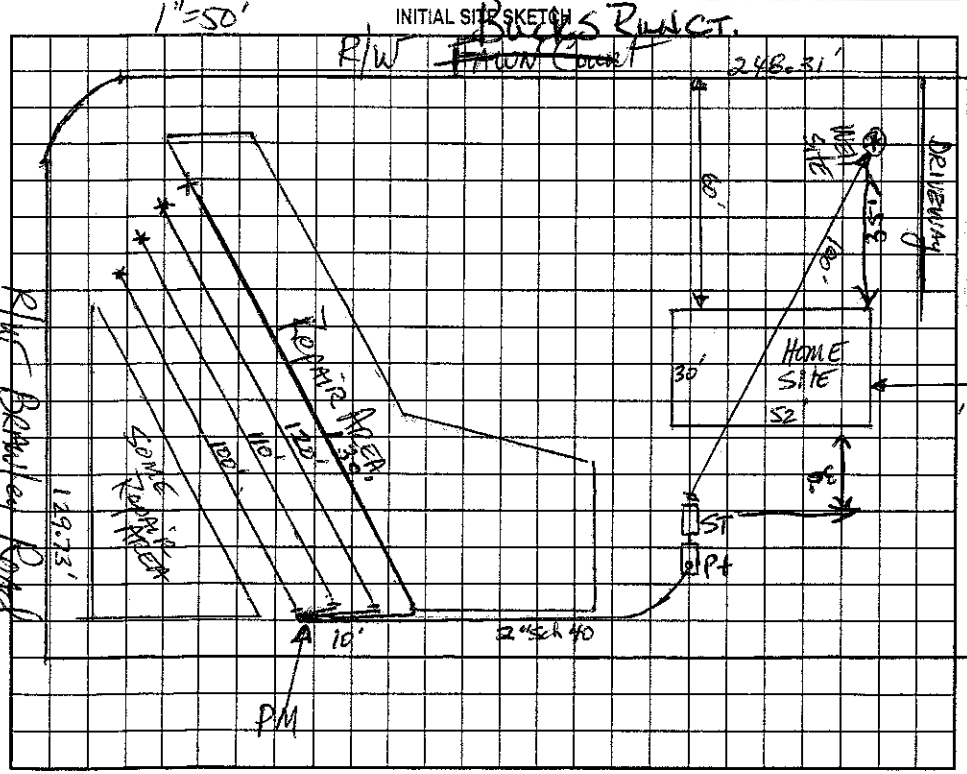

AS BUILT SKETCH

Permit can be suspended or revoked if any false information is supplied toward securing the permit/any unauthorized changes are made to the site/any unauthorized changes are made in the installation of the system. Improvement Permit with plat valid without expiration. Improvement Permit with site plan valid for sixty months. Authorization to Construct is valid for a period equal to that of Improvement Permit – not to exceed sixty months.

Signed: [signature] date 12/22/99 Installed by: A1 Backhoe

Improvement Permit by: Mark R. Johnson, RS date 12-14-99 Operation Permit by: Wesley Sparks date 4/11/00

Authorization to Construct by: Mark R. Johnson, RS date 12-14-99 Existing System Inspection by: date

HEALTH DEPT. COPY: WHITE OWNER COPY (FINAL): YELLOW OWNER COPY (INITIAL): PINK