IREDELL COUNTY HEALTH DEPARTMENT

STATESVILLE 704-878-5305 MOORESVILLE 704-664-5281

IMPROVEMENT PERMIT / AUTHORIZATION TO CONSTRUCT / OPERATION PERMIT / EXISTING SYSTEM INSPECTION

PERMIT# 083930 PIN# ~~4761653580 (pt)~~ 4761-53-2829 DATE Dec. 13, '99

OWNER OR CONTRACTOR Deer Valley LLC PHONE: Business 664-9080 Home

ADDRESS 255 Rolling Hills Rd. Mooresville

LOCATION 0.15-21N TR Bostwalt-Amity TR Brawley Rd. on Right

SUBDIVISION Deer Valley BLOCK / SECTION LOT 24 LOT AREA .90Ac SITE CLASS. IPS DESIGN FLOW 360gpd L.T.A.R. .3

Septic Tank: 1000 Gallons; STB 1012 Date 12/6/99
Pump Tank: Gallons; PT Date
Pump Make: Model Serial No.
Nitrification Field: No Fields 1 Square Feet 1200 Linear Feet 400
No Lines 5@80' Trench Width 36" Max Trench Bottom Depth 36" Gravel Depth 12"

☑ New System ☐ Repair System Type: I, II, III, IV, V, VI
System Description: Gravity conventional
Repair System Description: Gravity Innovative
Maintenance Agreement Required: ☐ Yes ☑ No


☑ House/Mod. Home No. Bedrooms 3
☐ Mobile Home No. Bathrooms 2
☐ Business No. Employees
☐ Other
☐ Slab ☑ Crawl Space ☐ Basement w/plumbing ☐ Basement wo/plumbing

Water Supply: ☑ Individual ☐ Public ☐ Community


Comments:/Conditions:
5-24-00 Talked w/ well driller (Jamie Russell) - 6" Well has gone dry within approx 2 months. He does not believe going deeper (well is already 500') or staying / shifting over in front yard will solve problem. He wants to drill

Comments:/Conditions:
New well at left rear lot corner. With proper well abandonment there should be 100% repair area in the front yard and off left rear of mobile home combined.

INITIAL SITE SKETCH 1"=50'

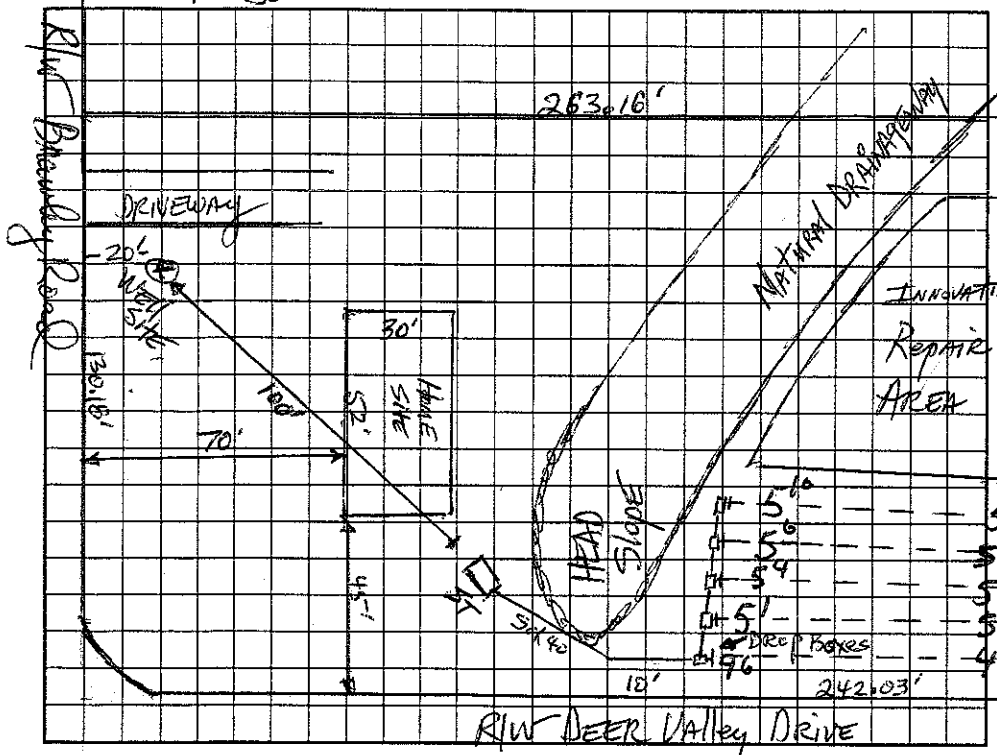

AS BUILT SKETCH

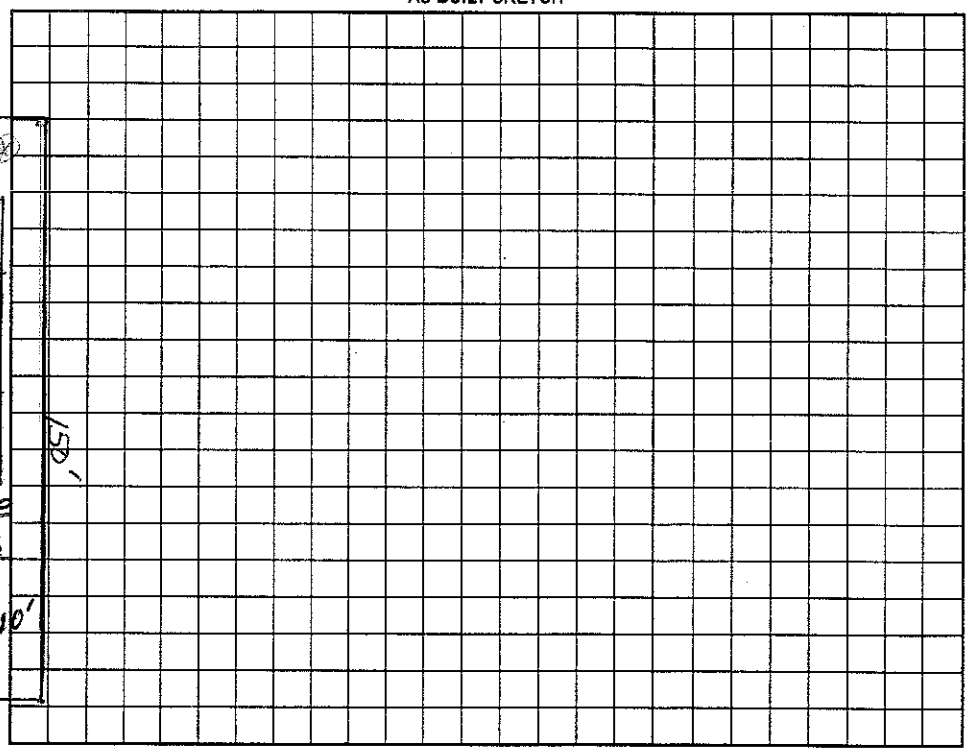

Permit can be suspended or revoked if any false information is supplied toward securing the permit/any unauthorized changes are made to the site/any unauthorized changes are made in the installation of the system. Improvement Permit with plat valid without expiration. Improvement Permit with site plan valid for sixty months. Authorization to Construct is valid for a period equal to that of Improvement Permit – not to exceed sixty months.

Signed: [signature] date 12/22/99 Installed by: A1 Backhoe

Improvement Permit by: [signature] date 12-13-99 Operation Permit by: C. [signature] date 3/29/00

Authorization to Construct by: [signature] date 12-13-99 Existing System Inspection by: date

HEALTH DEPT. COPY: WHITE OWNER COPY (FINAL): YELLOW OWNER COPY (INITIAL): PINK