3,00

IREDELL COUNTY HEALTH DEPARTMENT

STATESVILLE 704-878-5305 MOORESVILLE 704-664-5281

IMPROVEMENT PERMIT / AUTHORIZATION TO CONSTRUCT / OPERATION PERMIT / EXISTING SYSTEM INSPECTION

PERMIT# 106218 PIN# ~~4761651580.61~~ 4761-53-6647 DATE 5/28/02

OWNER OR CONTRACTOR LEADER HOMES PHONE: Business Home

ADDRESS PO BOX 1101 MOORESVILLE

LOCATION OSWALT ANDY - TR BRAWLEY - 8th ON LT

SUBDIVISION DEERVALLEY BLOCK / SECTION 4 LOT 61 LOT AREA 1.324AC SITE CLASS. PS DESIGN FLOW 360GPD L.T.A.R. ~~.25~~ .22/KFT²

Septic Tank: 1000 Gallons; STB 794 Date 5/14/02
Pump Tank: Gallons; PT Date
Pump Make: Model Serial No.
Nitrification Field: No Fields 1 Square Feet 1428 Linear Feet 476
No Lines 7@68' Trench Width 36" Max Trench Bottom Depth 36" Gravel Depth 12"

☑ New System ☐ Repair System Type: I, II, III, IV, V, VI
System Description: GRAVITY CONVENTIONAL
Repair System Description: SAME
Maintenance Agreement Required: ☐ Yes ☑ No


☑ House/Mod. Home No. Bedrooms 3
☐ Mobile Home No. Bathrooms 3
☐ Business No. Employees
☐ Other
☐ Slab ☑ Crawl Space ☐ Basement w/plumbing ☐ Basement wo/plumbing

Water Supply: ☑ Individual ☐ Public ☐ Community


Comments:/Conditions:

Comments:/Conditions:

INITIAL SITE SKETCH 1" = 60'

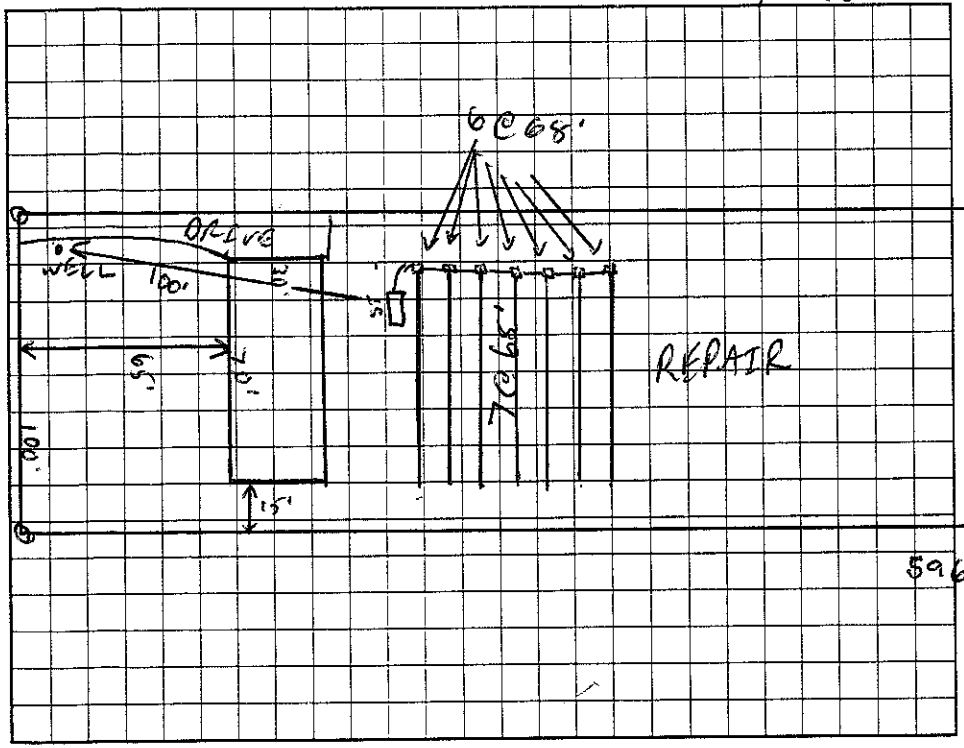

AS BUILT SKETCH

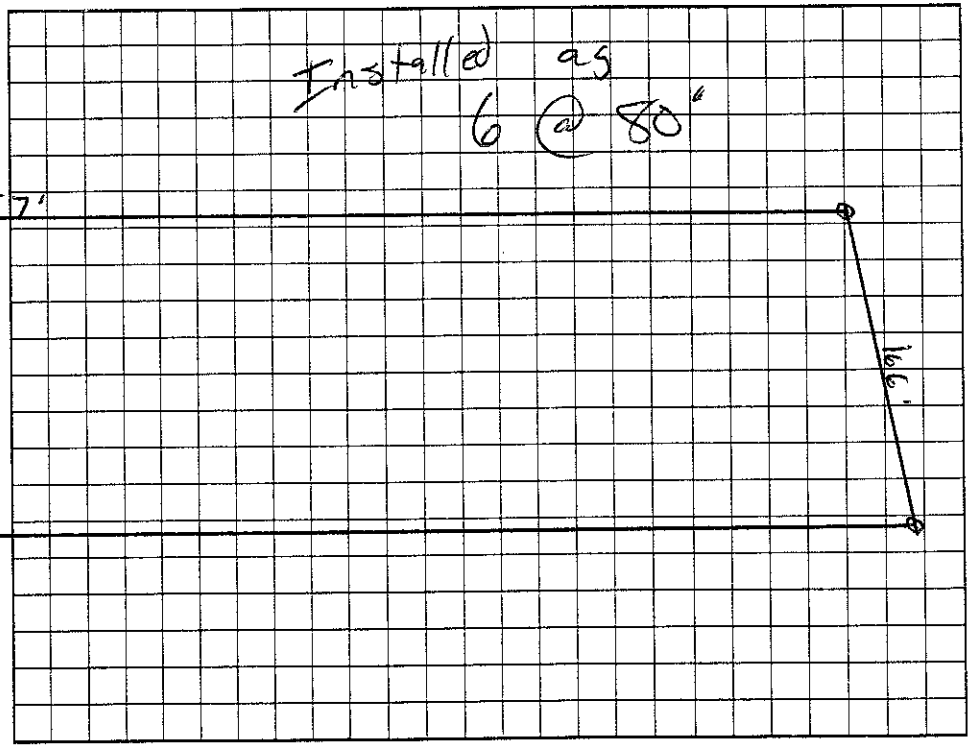

BRAWLEY RD

Permit can be suspended or revoked if any false information is supplied toward securing the permit/any unauthorized changes are made to the site/any unauthorized changes are made in the installation of the system. Improvement Permit with plat valid without expiration. Improvement Permit with site plan valid for sixty months. Authorization to Construct is valid for a period equal to that of Improvement Permit – not to exceed sixty months.

Signed: Tracy A Poole date 5-28-02 Installed by: Larry Tucker

Improvement Permit by: RS date 5/28/02 Operation Permit by: RS date 6/5/02

Authorization to Construct by: RS date 5/28/02 Existing System Inspection by: date

HEALTH DEPT. COPY: WHITE OWNER COPY (FINAL): YELLOW OWNER COPY (INITIAL): PINK