IREDELL COUNTY HEALTH DEPARTMENT

STATESVILLE 704-878-5305 MOORESVILLE 704-664-5281

IMPROVEMENT PERMIT / AUTHORIZATION TO CONSTRUCT / OPERATION PERMIT / EXISTING SYSTEM INSPEC..O

PERMIT# 106217 PIN# ~~4706651580, 60~~ 4761-53-6766 DATE 1/7/03

OWNER OR CONTRACTOR DEERVALLEY LLC PHONE: Business 664-9080 Home

ADDRESS 255 ROLLING HILLS DR.

LOCATION OSWALT AMITY - TR BRAWLEY RD - ON LT

SUBDIVISION DEERVALLEY BLOCK / SECTION 4 LOT 60 LOT AREA 1.236AC SITE CLASS. PS DESIGN FLOW 360GPD L.T.A.R. .13GPD/Ft²

Septic Tank: 1000 Gallons; STB 1012 Date 5/27/02

Pump Tank: Gallons; PT Date

Pump Make: Model Serial No.

Nitrification Field: No Fields 1 Square Feet 1200 Linear Feet 400

No Lines 6@67' Trench Width 36" Max Trench Bottom Depth 24" Gravel Depth

☑ ~~New System~~ ☐ Repair System Type: I, II, III, IV, V, VI

System Description: GRAVITY CONVENTIONAL

Repair System Description: SAME

Maintenance Agreement Required: ☐ Yes ☑ ~~No~~

☑ ~~House/Mod. Home~~ No. Bedrooms 3

☑ ~~Mobile Home~~ No. Bathrooms 3

☐ Business No. Employees

☐ Other


☐ Slab ☑ ~~Crawl Space~~ ☐ Basement w/plumbing ☐ Basement wo/plumbing

Water Supply: ☑ ~~Individual~~ ☐ Public ☐ Community


Comments:/Conditions: TANK MAY BE SWITCHED TO OTHER SIDE

Comments:/Conditions:

INITIAL SITE SKETCH 1"=60'

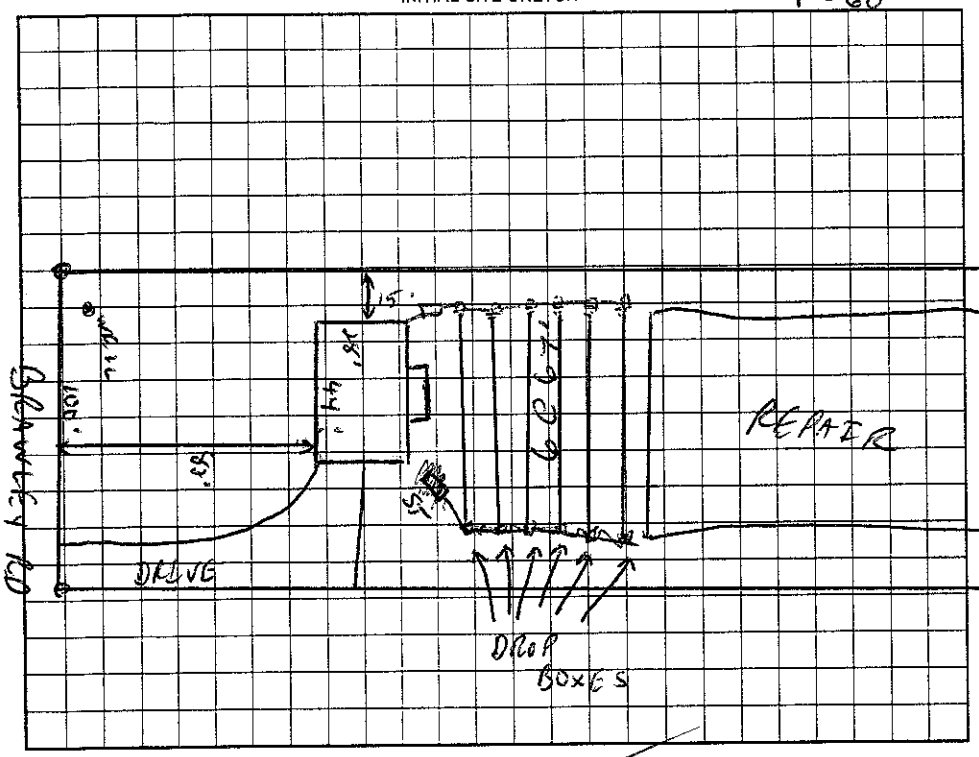

AS BUILT SKETCH

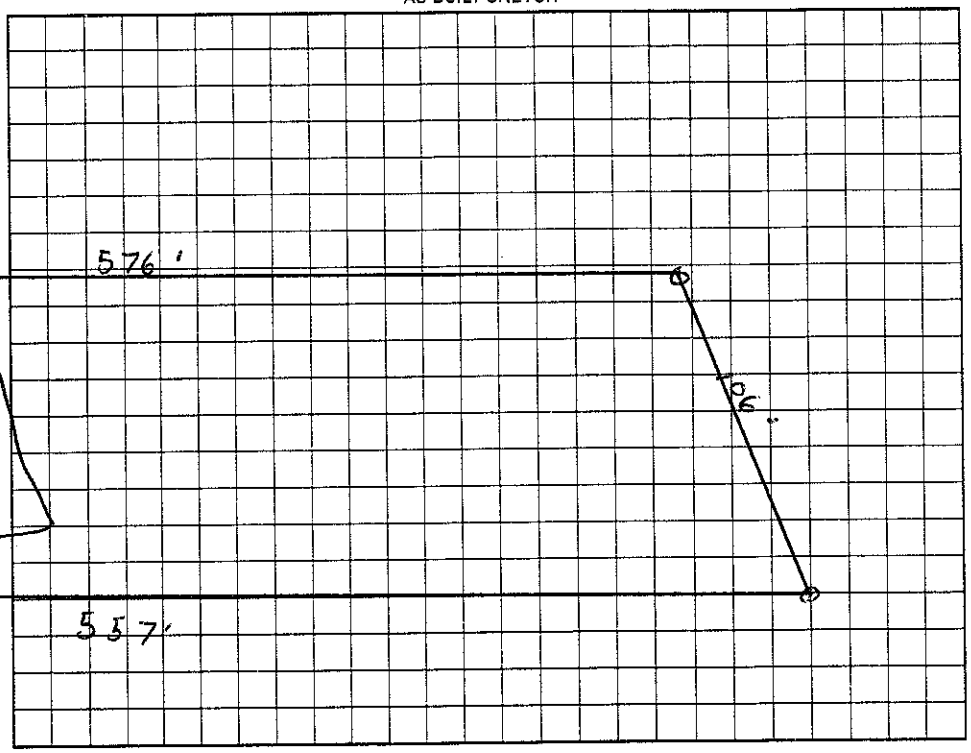

Permit can be suspended or revoked if any false information is supplied toward securing the permit/any unauthorized changes are made to the site/any unauthorized changes are made in the installation of the system. Improvement Permit with plat valid without expiration. Improvement Permit with site plan valid for sixty months. Authorization to Construct is valid for a period equal to that of Improvement Permit – not to exceed sixty months.

Signed: date

Improvement Permit by: RS date 1/7/03

Authorization to Construct by: RS date 1/7/03

Installed by: A-1 Backhoe

Operation Permit by: RS date 2/6/03

Existing System Inspection by: date

HEALTH DEPT. COPY: WHITE OWNER COPY (FINAL): YELLOW OWNER COPY (INITIAL): PINK