IREDELL COUNTY HEALTH DEPARTMENT

STATESVILLE 704-878-5305 MOORESVILLE 704-664-5281

IMPROVEMENT PERMIT / AUTHORIZATION TO CONSTRUCT / OPERATION PERMIT / EXISTING SYSTEM INSPECTION

PERMIT# 106216 PIN# ~~4761653580.59~~ 4761-53-6877 DATE 6-28-05

OWNER OR CONTRACTOR Expression Homes PHONE: Business 528-7960 Home

ADDRESS 1042 Charlotte Hwy Troutman, NC 28166

LOCATION Oswalt Amity Rd TR Brawley Rd on left

SUBDIVISION Deer Valley BLOCK / SECTION 4 LOT 59 LOT AREA 1.147 Acre SITE CLASS. PS DESIGN FLOW 360gpd L.T.A.R. .3 (.25 Repair)

Septic Tank: 1000 Gallons; STB 1012 Date 10-7-04

Pump Tank: Gallons; PT Date

Pump Make: Model Serial No.

Nitrification Field: No Fields 1 Square Feet 900 Linear Feet 300

No Lines 3 @ 100' Trench Width 36" Max Trench Bottom Depth 24" Gravel Depth N/A

☒ New System ☐ Repair System Type: I, II, III, IV, V, VI

System Description: Gravity 25% Reduction

Repair System Description: Same

Maintenance Agreement Required: ☐ Yes ☒ No

☐ House/Mod. Home No. Bedrooms 3

☐ Mobile Home No. Bathrooms 2

☐ Business No. Employees

☐ Other


☐ Slab ☐ Crawl Space ☐ Basement w/plumbing ☐ Basement wo/plumbing

Water Supply: ☒ Individual ☐ Public ☐ Community


Comments:/Conditions:

Comments:/Conditions: Installed "Plastic Chambers" @ 24" trench bottom

INITIAL SITE SKETCH Scale 1:60

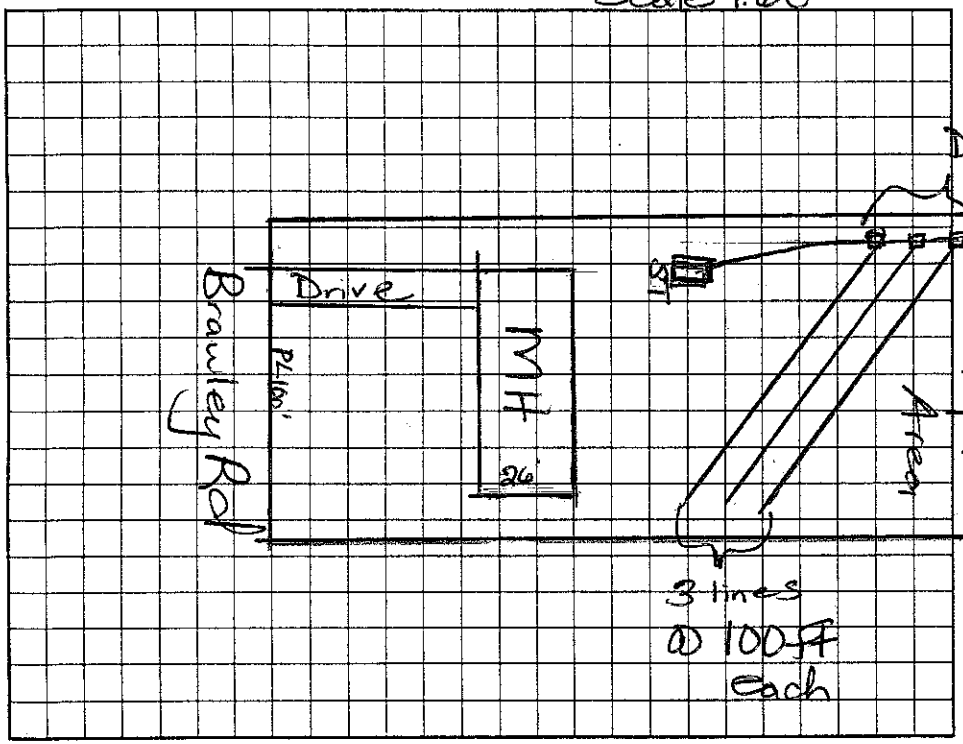

AS BUILT SKETCH

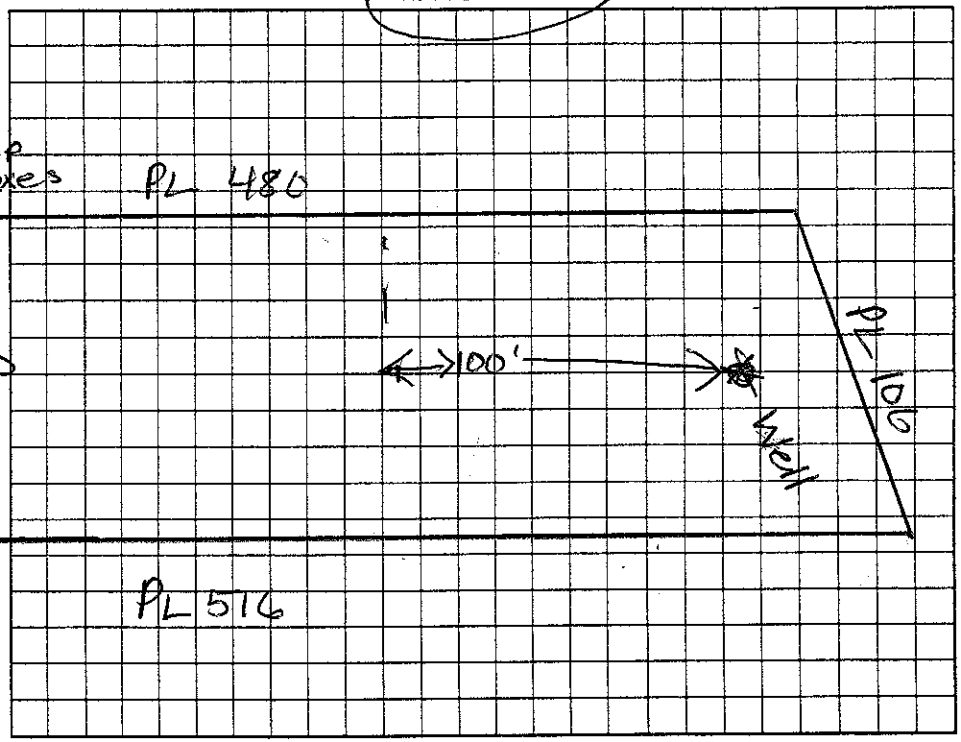

Permit can be suspended or revoked if any false information is supplied toward securing the permit/any unauthorized changes are made to the site/any unauthorized changes are made in the installation of the system. Improvement Permit with plat valid without expiration. Improvement Permit with site plan valid for sixty months. Authorization to Construct is valid for a period equal to that of Improvement Permit – not to exceed sixty months.

Signed: date

Improvement Permit by: date

Authorization to Construct by: date

Installed by: Craig Thompson RS

Operation Permit by: Mathis Hall Dotson RS date 6/28/05

Existing System Inspection by: date

HEALTH DEPT. COPY: WHITE OWNER COPY (FINAL): YELLOW OWNER COPY (INITIAL): PINK