1:30

IREDELL COUNTY HEALTH DEPARTMENT

STATESVILLE 704-878-5305 MOORESVILLE 704-664-5281

IMPROVEMENT PERMIT / AUTHORIZATION TO CONSTRUCT / OPERATION PERMIT / EXISTING SYSTEM INSPECTION

PERMIT# 106212 PIN# ~~4761651580.58~~ 4761-53-7906 DATE 7/30/02

OWNER OR CONTRACTOR DEERVALLEY LLC / Freedom Homes PHONE: Business 664-9080 Home

ADDRESS 255 ROLLING MILLS DR. MOORESVILLE

LOCATION OSWALT AMITY - TR BRAWLEY RD - ON LT

SUBDIVISION DEER VALLEY BLOCK / SECTION Y LOT 58 LOT AREA 1.477C SITE CLASS. CS DESIGN FLOW ~~360~~ 360 L.T.A.R. .25000/AC

Septic Tank: 1000 Gallons; STB 960 Date 3-28-06

Pump Tank: Gallons; PT Date

Pump Make: Model Serial No.

Nitrification Field: No Fields 1 Square Feet 1440 Linear Feet 480

No Lines 6@80' Trench Width 36" Max Trench Bottom Depth 24" Gravel Depth

☑ New System ☐ Repair System Type: I II III IV V VI

System Description: C-RAVEN ~~EVAPORATIVE~~ LPP Conventional

Repair System Description:

Maintenance Agreement Required: ☐ Yes ☑ No

☑ House/Mod. Home No. Bedrooms ~~3~~ 4

☐ Mobile Home No. Bathrooms ~~2~~

☐ Business No. Employees

☐ Other

☐ Slab ☑ Crawl Space ☐ Basement w/plumbing ☐ Basement wo/plumbing

Water Supply: ☐ ~~Individual~~ ☐ Public ☐ Community


Comments:/Conditions: Change to 3bedroom - Conventional GM 7/11/06

Comments:/Conditions:


Red Poly-tek filter

5 lines Quick 4 installed as per initial sketch @ 72' w/ drop boxes

INITIAL SITE SKETCH 1"=60'

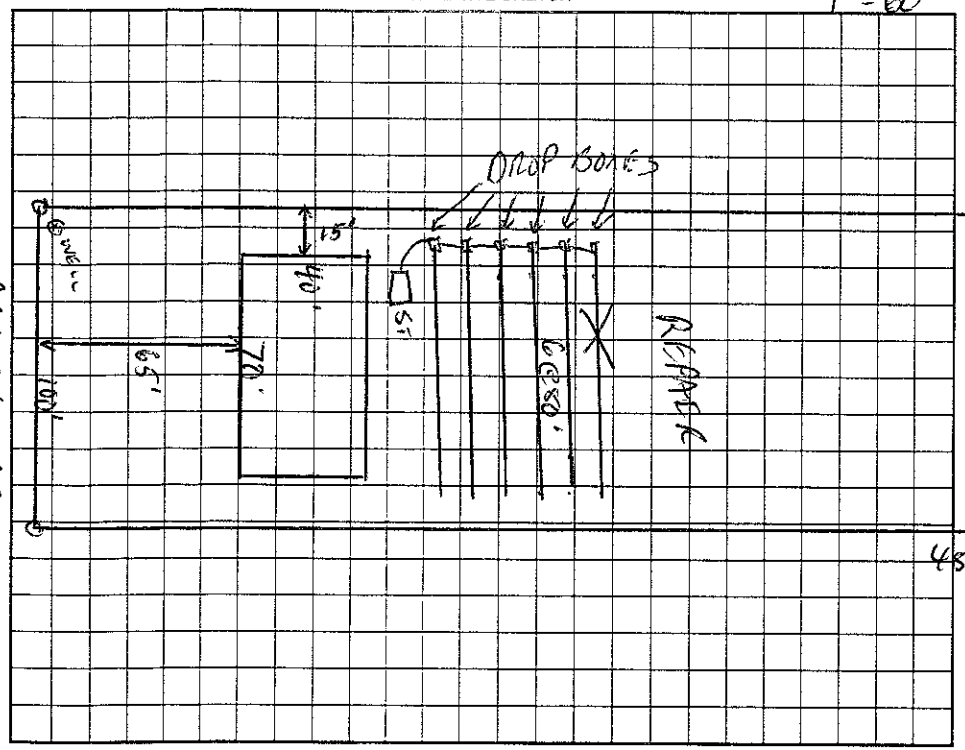

AS BUILT SKETCH

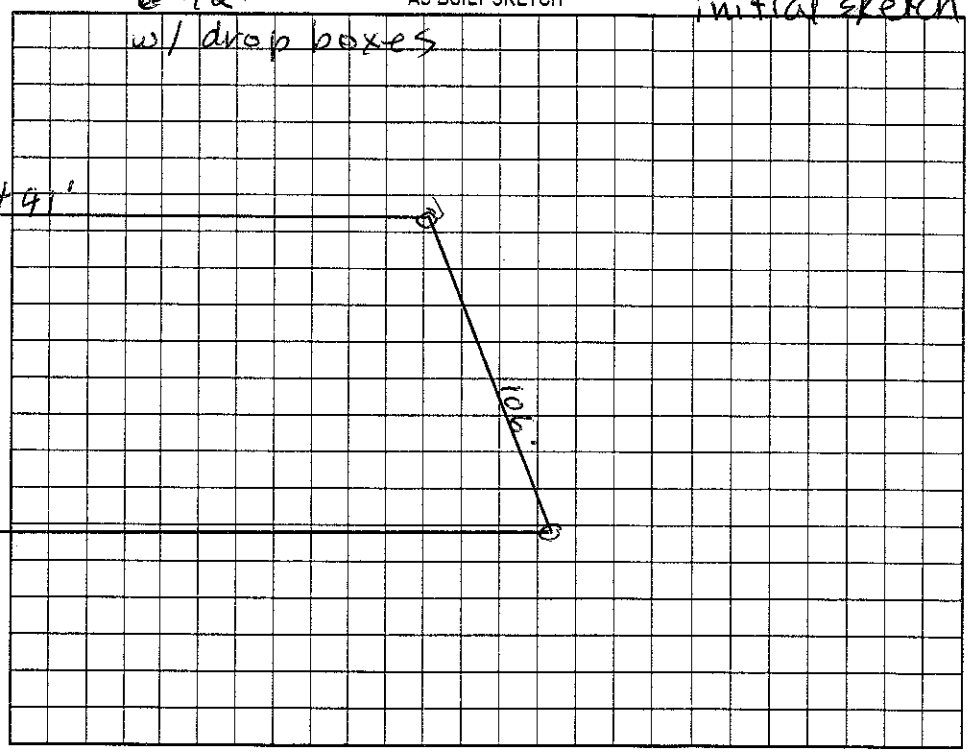

Permit can be suspended or revoked if any false information is supplied toward securing the permit/any unauthorized changes are made to the site/any unauthorized changes are made in the installation of the system. Improvement Permit with plat valid without expiration. Improvement Permit with site plan valid for sixty months. Authorization to Construct is valid for a period equal to that of Improvement Permit – not to exceed sixty months.

Signed: date

Improvement Permit by: date 7/30/02

Authorization to Construct by: date 7/11/06

Installed by: Abee's Grading Tim 336-240-8298

Operation Permit by: date 7-25-06

Existing System Inspection by: date

HEALTH DEPT. COPY: WHITE OWNER COPY (FINAL): YELLOW OWNER COPY (INITIAL): PINK