IREDELL COUNTY HEALTH DEPARTMENT

STATESVILLE 704-878-5305 MOORESVILLE 704-664-5281

IMPROVEMENT PERMIT / AUTHORIZATION TO CONSTRUCT / OPERATION PERMIT / EXISTING SYSTEM INSPECTION

PERMIT# 062717 PIN# ~~4761 65 1580 (pt)~~ 4761-54-0675 DATE Dec 2, '99

OWNER OR CONTRACTOR Deer Valley Dev. Group LLC PHONE: Business 664-9080 Home

ADDRESS 253 Rolling Hills Rd. Mooresville

LOCATION I-77 exit 36 (Mooresville) I-21 N. TR Oswalt-Amity Road on Right before Brawley Road

SUBDIVISION Deer Valley BLOCK / SECTION LOT 48 LOT AREA 1.01 AC SITE CLASS. 5 DESIGN FLOW 360 gpd L.T.A.R. .25 ±

Septic Tank: 1000 Gallons; STB 794 Date 4/25/00
Pump Tank: Gallons; PT Date
Pump Make: Model Serial No.
Nitrification Field: No Fields 1 Square Feet 1500 Linear Feet 500
No Lines 5 @ 100' Trench Width 36" Trench Bottom Depth 36"+ Gravel Depth 12"

☑ New System ☐ Repair System Type: I, II, III, IV, V, VI
System Description: Gravity Conventional
Repair System Description: Same
Maintenance Agreement Required: ☐ Yes ☑ No

☑ House/Mod. Home No. Bedrooms 3
☐ Mobile Home No. Bathrooms 2
☐ Business No. Employees
☐ Other
☐ Slab ☑ Crawl Space ☐ Basement w/plumbing ☐ Basement wo/plumbing


Water Supply: ☑ Individual ☐ Public ☐ Community

Comments:/Conditions: Install trenches at 36" trench bottom depth.


Comments:/Conditions:

1" = 50'

INITIAL SITE SKETCH

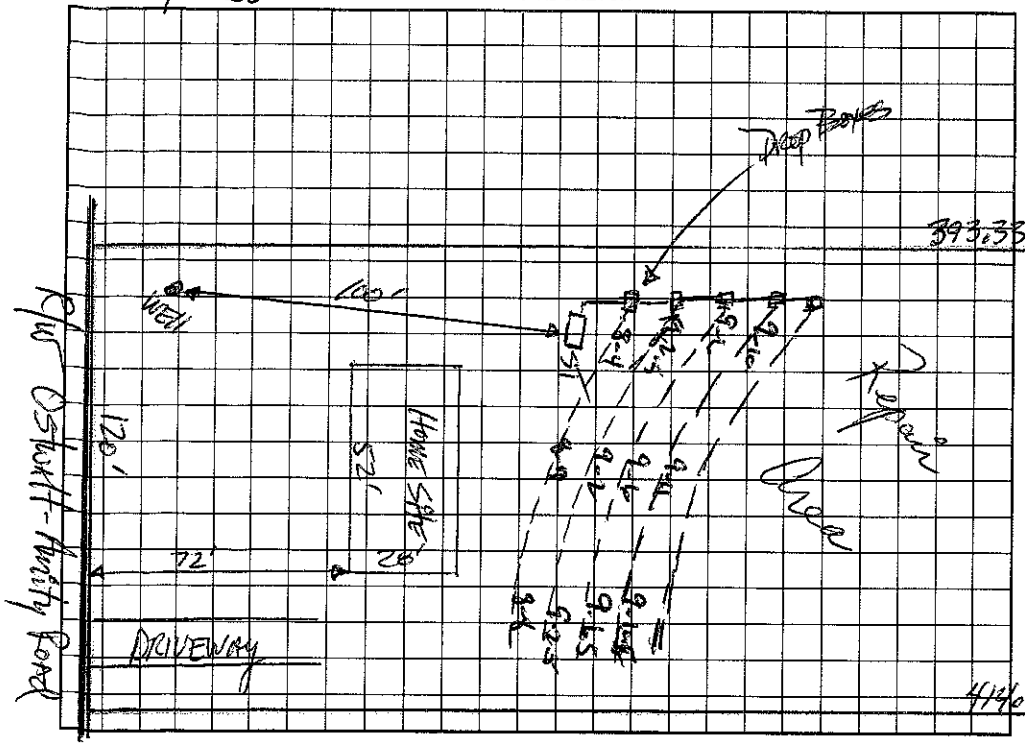

AS BUILT SKETCH

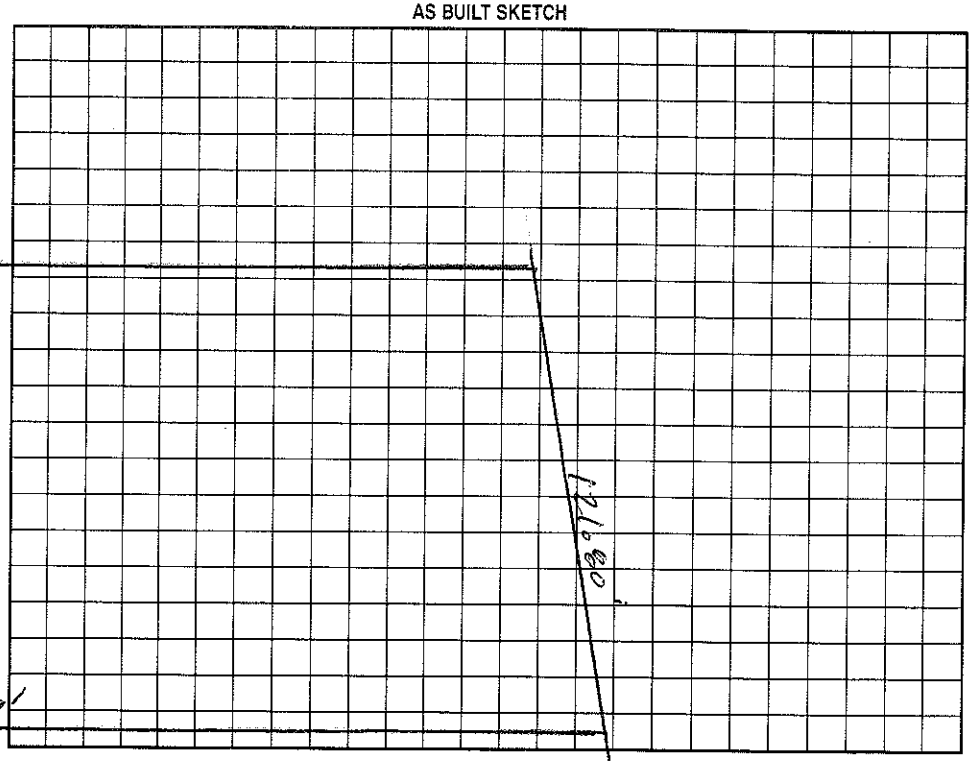

Permit can be suspended or revoked if any false information is supplied toward securing the permit/any unauthorized changes are made to the site/any unauthorized changes are made in the installation of the system. Improvement Permit with plat valid without expiration. Improvement Permit with site plan valid for sixty months. Authorization to Construct is valid for a period equal to that of Improvement Permit – not to exceed sixty months.

Signed: Jane E McDowell date 12/8/99 Installed by: Michael Tucker

Improvement Permit by: [signature], RS date 12-2-99 Operation Permit by: Wesley Sparks RS. date 6/26/00

Authorization to Construct by: [signature], RS date 12-2-99 Existing System Inspection by: date

HEALTH DEPT. COPY: WHITE OWNER COPY (FINAL): YELLOW OWNER COPY (INITIAL): PINK