IREDELL COUNTY HEALTH DEPARTMENT

STATESVILLE 704-878-5305 MOORESVILLE 704-664-5281

IMPROVEMENT PERMIT / AUTHORIZATION TO CONSTRUCT / OPERATION PERMIT / EXISTING SYSTEM INSPECTION

PERMIT# 88718 PIN# ~~4761651580 RT~~ 4761-54-1253 DATE 6/19/00

OWNER OR CONTRACTOR DEER VALLEY LLC PHONE: Business 664-9080 Home

ADDRESS 255 ROLLING HILLS DRIVE MOORESVILLE, NC 28117

LOCATION 21/115 N - TR OSWALT AMITY - TR BRAWLEY [redacted] RD - TR DEER VALLEY - ON RT

SUBDIVISION DEER VALLEY BLOCK / SECTION 3 LOT 43 LOT AREA .92AC SITE CLASS. PS DESIGN FLOW 360GPD L.T.A.R. .30PD/FT²

Septic Tank: 1000 Gallons; STB 1012 Date 2/2/00
Pump Tank: _____ Gallons; PT _____ Date _____
Pump Make: _____ Model _____ Serial No. _____
Nitrification Field: No Fields 1 Square Feet 1200 Linear Feet 400
No Lines 4@100' Trench Width 36" Max Trench Bottom Depth 36" Gravel Depth N/A

☑ New System ☐ Repair System Type: I II III IV V VI
System Description: GRAVITY CONVENTIONAL
Repair System Description: SAME
Maintenance Agreement Required: ☐ Yes ☑ No


☐ House/Mod. Home No. Bedrooms 3
☑ Mobile Home No. Bathrooms 3
☐ Business No. Employees
☐ Other
☐ Slab ☑ Crawl Space ☐ Basement w/plumbing ☐ Basement wo/plumbing

Water Supply: ☑ Individual ☐ Public ☐ Community


Comments:/Conditions: 1) KEEP WELL 100' FROM SYSTEM AND AT LEAST 90' FROM RIGHT PROPERTY LINE. 2) HOUSE CANNOT BE ADJUSTED MUCH BECAUSE LOT SLOPES IN BOTH DIRECTIONS. IF HOUSE IS MOVED FORWARD, SYSTEM

Comments:/Conditions: WELL HAVE TO BE PUMPED.
* WELL NOT LOCATED AT TIME OF INSPECTION*
6/22/00 CSP

INITIAL SITE SKETCH (1" = 50')

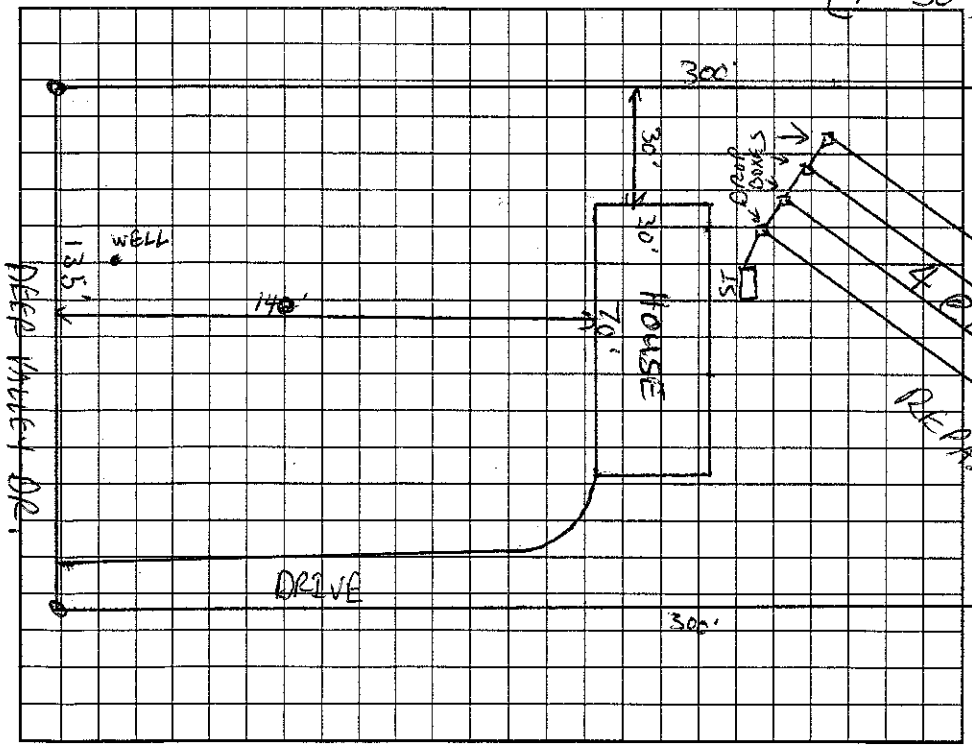

AS BUILT SKETCH

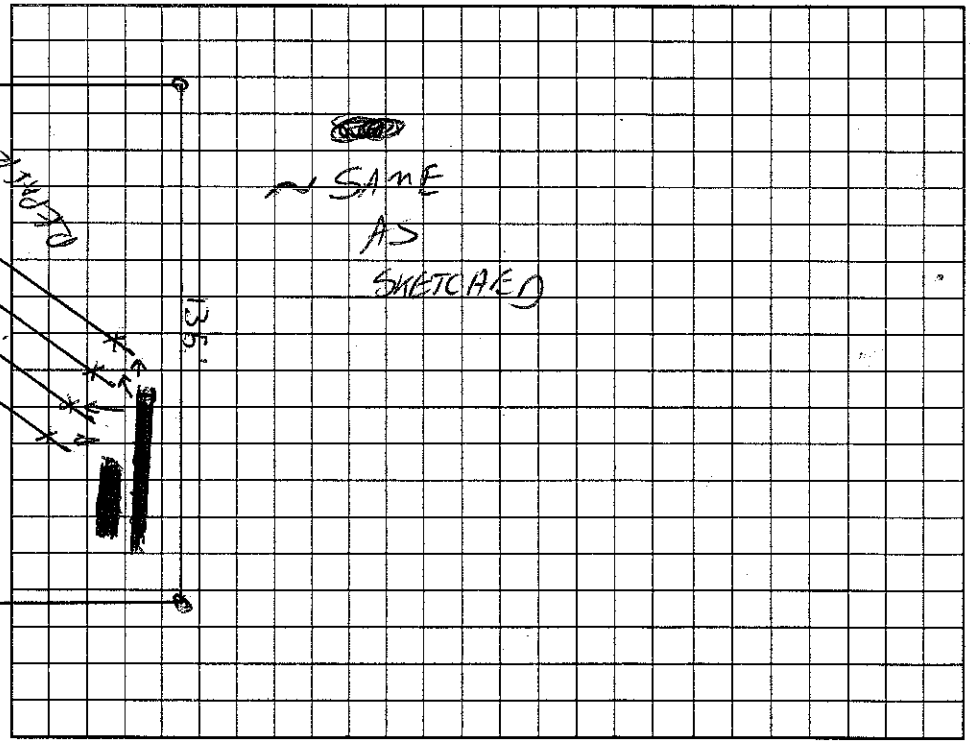

Permit can be suspended or revoked if any false information is supplied toward securing the permit/any unauthorized changes are made to the site/any unauthorized changes are made in the installation of the system. Improvement Permit with plat valid without expiration. Improvement Permit with site plan valid for sixty months. Authorization to Construct is valid for a period equal to that of Improvement Permit – not to exceed sixty months.

Signed: Dennos Dallicker date 6-21-00 Installed by: A1 BACKHOE

Improvement Permit by: C. Bly RS date 6/19/00 Operation Permit by: C Bly RS date 6/22/00

Authorization to Construct by: C. Bly RS date 6/19/00 Existing System Inspection by: _____ date _____

HEALTH DEPT. COPY: WHITE OWNER COPY (FINAL): YELLOW OWNER COPY (INITIAL): PINK