IREDELL COUNTY HEALTH DEPARTMENT

STATESVILLE 704-878-5305 MOORESVILLE 704-664-5281

IMPROVEMENT PERMIT / AUTHORIZATION TO CONSTRUCT / OPERATION PERMIT / EXISTING SYSTEM INSPECTION

PERMIT# 082714 PIN# ~~4761-65-1580 (pt)~~ 4761-54-1680 DATE Dec. 2, '99

OWNER OR CONTRACTOR Deer Valley Dev. Group LLC PHONE: Business 664-9080 Home

ADDRESS 255 Rolling Hills Road Mooresville

LOCATION 115-21N TR Ostwalt-Amity on Right just before Brawley Road

SUBDIVISION Deer Valley BLOCK / SECTION LOT 47 LOT AREA 1.05AC SITE CLASS. PS DESIGN FLOW 360gpd L.T.A.R. .3

Septic Tank: 1000 Gallons; STB 1012 Date 5/14/00

Pump Tank: Gallons; PT Date

Pump Make: Model Serial No.

Nitrification Field: No Fields 1 Square Feet 1200 Linear Feet 400

No Lines 4@100' Trench Width 36" Trench Bottom Depth 36"+ Gravel Depth 12"

☑ New System ☐ Repair System Type: I, II, III, IV, V, VI

System Description: GRAVITY CONVENTIONAL

Repair System Description: SAME

Maintenance Agreement Required: ☐ Yes ☑ No

☑ House/Mod. Home No. Bedrooms 3

☐ Mobile Home No. Bathrooms 2

☐ Business No. Employees

☐ Other

☐ Slab ☑ Crawl Space ☐ Basement w/plumbing ☐ Basement wo/plumbing


Water Supply: ☑ Individual ☐ Public ☐ Community

Comments:/Conditions: * May use Drop Boxes if preferred
INSTALL trenches at 36" trench bottom depth.


Comments:/Conditions:

1" = 50'

INITIAL SITE SKETCH

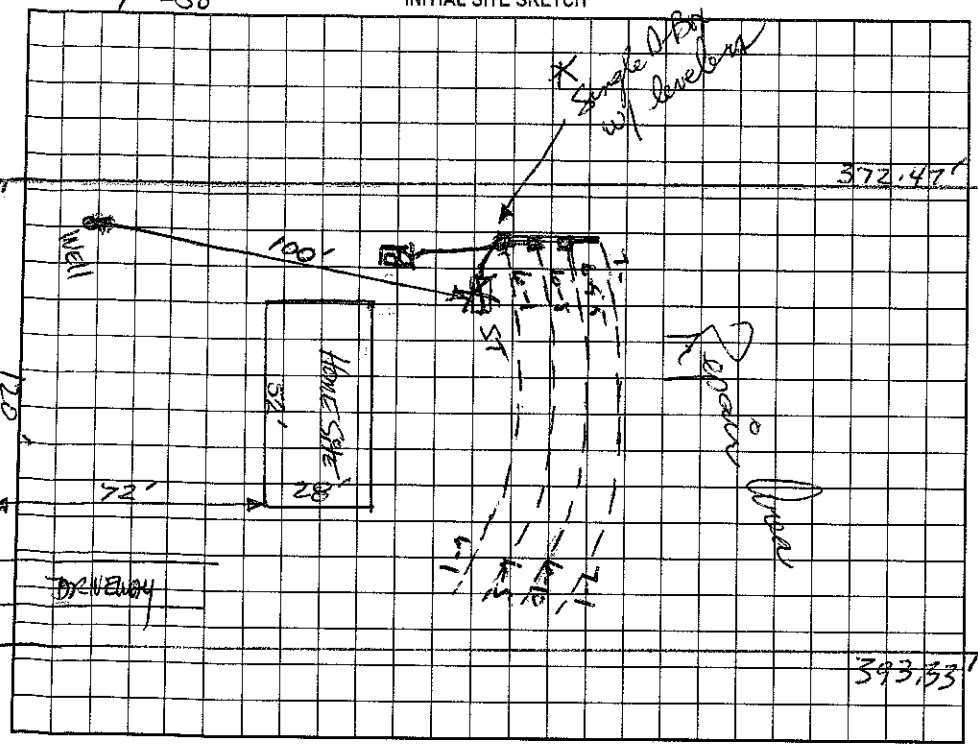

AS BUILT SKETCH

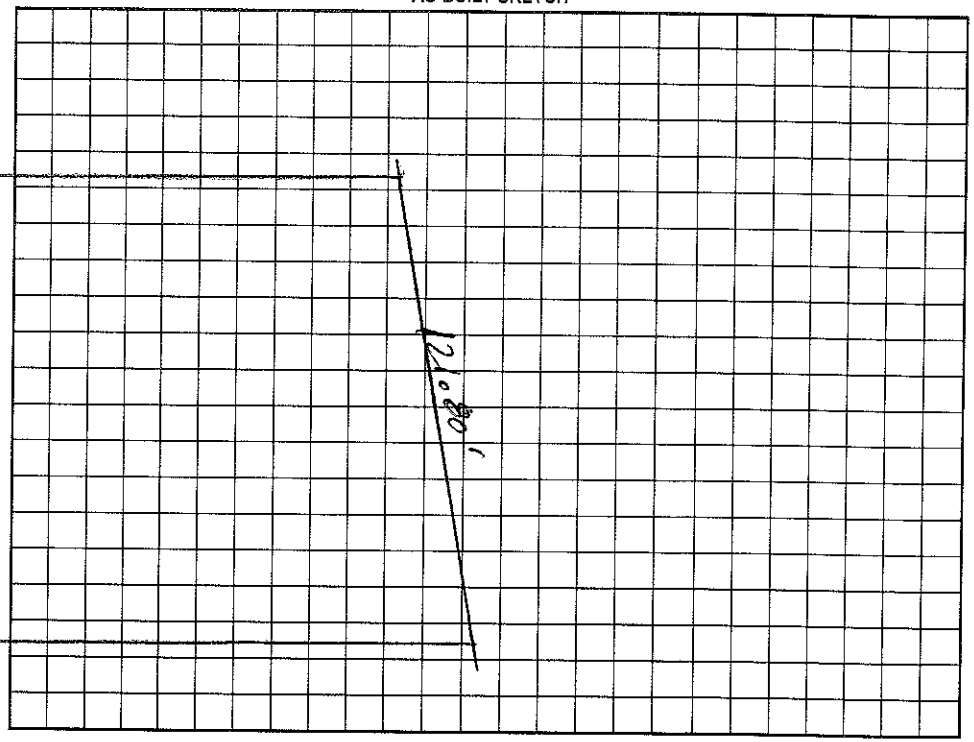

Permit can be suspended or revoked if any false information is supplied toward securing the permit/any unauthorized changes are made to the site/any unauthorized changes are made in the installation of the system. Improvement Permit with plat valid without expiration. Improvement Permit with site plan valid for sixty months. Authorization to Construct is valid for a period equal to that of Improvement Permit – not to exceed sixty months.

Signed: James E Mashburn date 12/8/99 Installed by: A-1 Backhoe

Improvement Permit by: Wayne Robinson, RS date 12-2-99 Operation Permit by: Wesley Sparks date 9/20/00

Authorization to Construct by: Wayne Robinson, RS date 12-2-99 Existing System Inspection by: date

HEALTH DEPT. COPY: WHITE OWNER COPY (FINAL): YELLOW OWNER COPY (INITIAL): PINK