IREDELL COUNTY HEALTH DEPARTMENT

STATESVILLE 704-878-5305 MOORESVILLE 704-664-5281

IMPROVEMENT PERMIT / AUTHORIZATION TO CONSTRUCT / OPERATION PERMIT / EXISTING SYSTEM INSPECTION

PERMIT# 082713 PIN# 4761-65-1580 (pt.) 4761-54-2584 DATE Dec. 14 '99

OWNER OR CONTRACTOR Deer Valley Dev. Group LLC PHONE: Business 664-9080 Home

ADDRESS 255 Rolling Hills Rd. Mooresville

LOCATION 115-21N TR Ostwalt-Amity Rd on Right just before Brawley Rd.

SUBDIVISION Deer Valley BLOCK / SECTION LOT 46 LOT AREA .99AC SITE CLASS. RS DESIGN FLOW 360gpd L.T.A.R. .3 (Rear of Lot on 4)

Septic Tank: 1000 Gallons; STB 1012 Date 3/24/01

Pump Tank: 1000 Gallons; PT 17 Date 11/12/00

Pump Make: HYDRO Model SK50A1 Serial No. 3/01

Nitrification Field: No Fields 1 Square Feet 900 Linear Feet 300

No Lines 3@100' Trench Width 36" Max Trench Bottom Depth 36"

☑ New System ☐ Repair System Type: I, II, III, IV, V, VI

System Description: PM - Innovative - 25% Red.

Repair System Description: Similar on Panel Block

Maintenance Agreement Required: ☐ Yes ☑ No

Gravel Depth N/A

☑ House/Mod. Home No. Bedrooms 3

☐ Mobile Home No. Bathrooms 2

☐ Business No. Employees

☐ Other

☐ Slab ☑ Crawl Space ☐ Basement w/plumbing ☐ Basement wo/plumbing


Water Supply: ☑ Individual ☐ Public ☐ Community

Comments:/Conditions: * ONE INSPECTION PORT PER LATERAL
PROVIDE POSITIVE STORMWATER DRAINAGE AROUND HOME SITE & TANK LOCATIONS.


Comments:/Conditions:

1"=50'

INITIAL SITE SKETCH

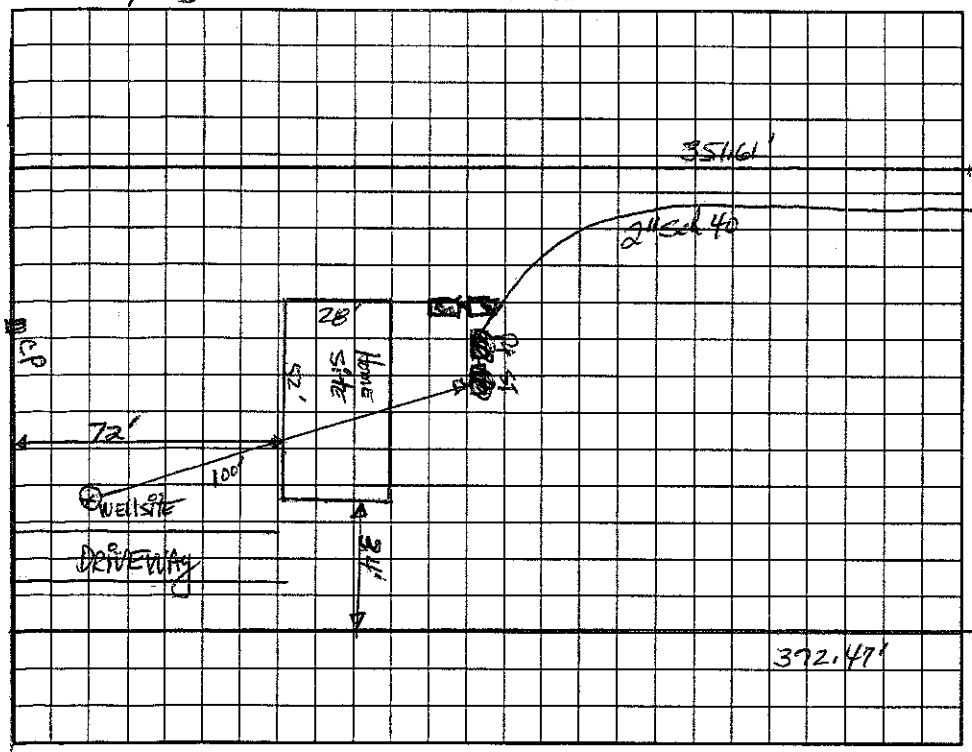

AS BUILT SKETCH

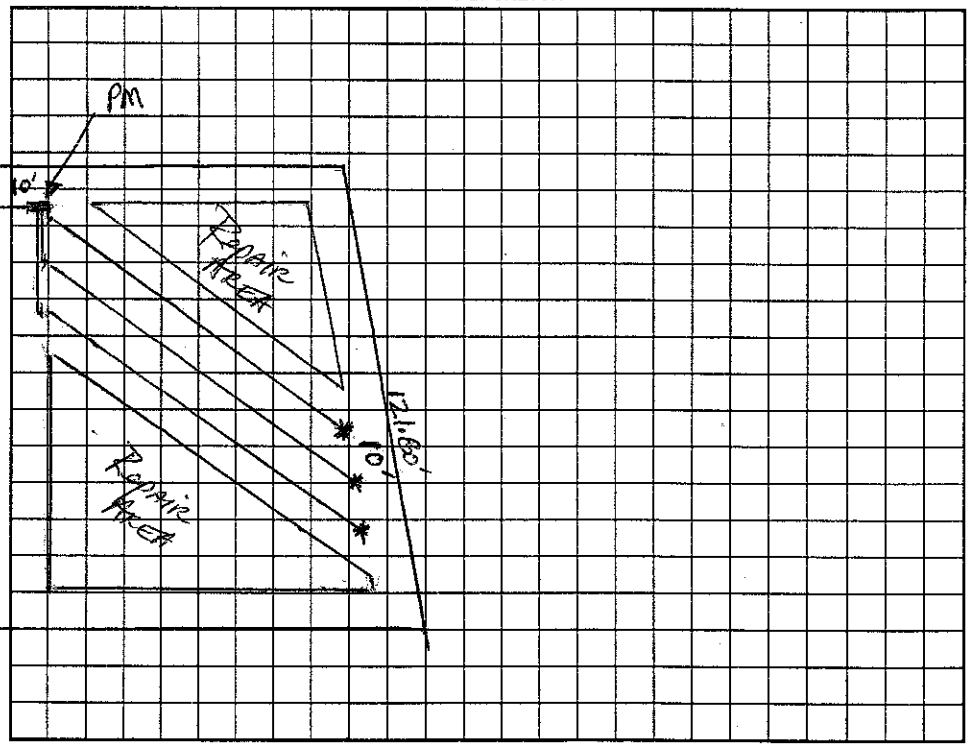

Permit can be suspended or revoked if any false information is supplied toward securing the permit/any unauthorized changes are made to the site/any unauthorized changes are made in the installation of the system. Improvement Permit with plat valid without expiration. Improvement Permit with site plan valid for sixty months. Authorization to Construct is valid for a period equal to that of Improvement Permit – not to exceed sixty months.

Signed: [signature] date 12-22-99 Installed by: A-1 Backhoe

Improvement Permit by: [signature], RS date 12-14-99 Operation Permit by: [signature] RS. date 7/20/01

Authorization to Construct by: [signature], RS date 12-14-99 Existing System Inspection by: date

HEALTH DEPT. COPY: WHITE OWNER COPY (FINAL): YELLOW OWNER COPY (INITIAL): PINK