1000

IREDELL COUNTY HEALTH DEPARTMENT

...RESVILLE 704-878-5305 MOORESVILLE 704-664-5281

IMPROVEMENT PERMIT / AUTHORIZATION TO CONSTRUCT / OPERATION PERMIT / EXISTING SYSTEM INSPECTION

PERMIT# 083933 PIN# ~~4766-57-5500 pt.~~ 4761-54-3008 DATE Dec 8, '99

OWNER OR CONTRACTOR Deer Valley Dev Group LLC PHONE: Business 664-9080 Home

ADDRESS 255 Rolling Hill Dr. Mooresville

LOCATION 115-2 N. TR Ostwalt-Amity Rd. TR Brawley Rd. on Right

SUBDIVISION Deer Valley BLOCK / SECTION LOT 44 LOT AREA .90Ac SITE CLASS. RS DESIGN FLOW 360gpd L.T.A.R. .035+

Septic Tank: 1000 Gallons; STB 1012 Date 11/29/00

Pump Tank: Gallons; PT Date

Pump Make: Model Serial No.

Nitrification Field: No Fields 1 Square Feet 1080 Linear Feet 360

No Lines 3@120' Trench Width 36" Max Trench Bottom Depth 36" Gravel Depth 12"

☑ New System ☐ Repair System Type: I, II, III, IV, V, VI

System Description: Gravity Conventional

Repair System Description: Same

Maintenance Agreement Required: ☐ Yes ☑ No

☑ House/Mod. Home No. Bedrooms 3

☐ Mobile Home No. Bathrooms 2

☐ Business No. Employees

☐ Other

☐ Slab ☑ Crawl Space ☐ Basement w/plumbing ☐ Basement wo/plumbing


Water Supply: ☑ Individual ☐ Public ☐ Community

Comments:/Conditions: Maintain 100' minimum well & Septic system Separation.


Comments:/Conditions:

INITIAL SITE SKETCH

1" = 50'

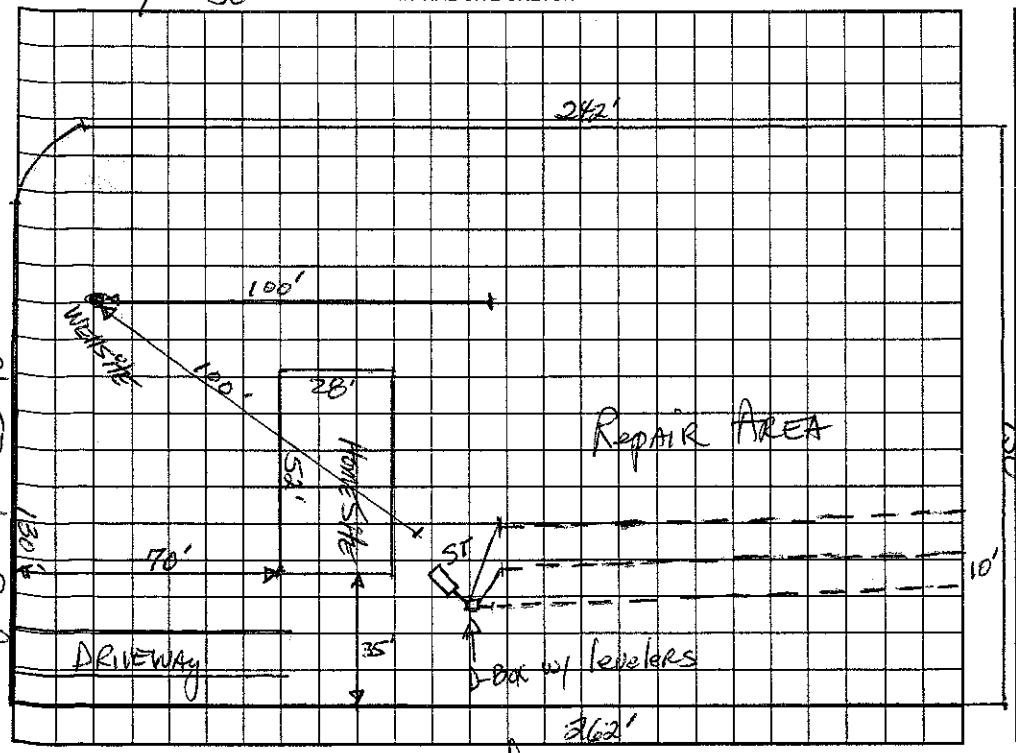

AS BUILT SKETCH

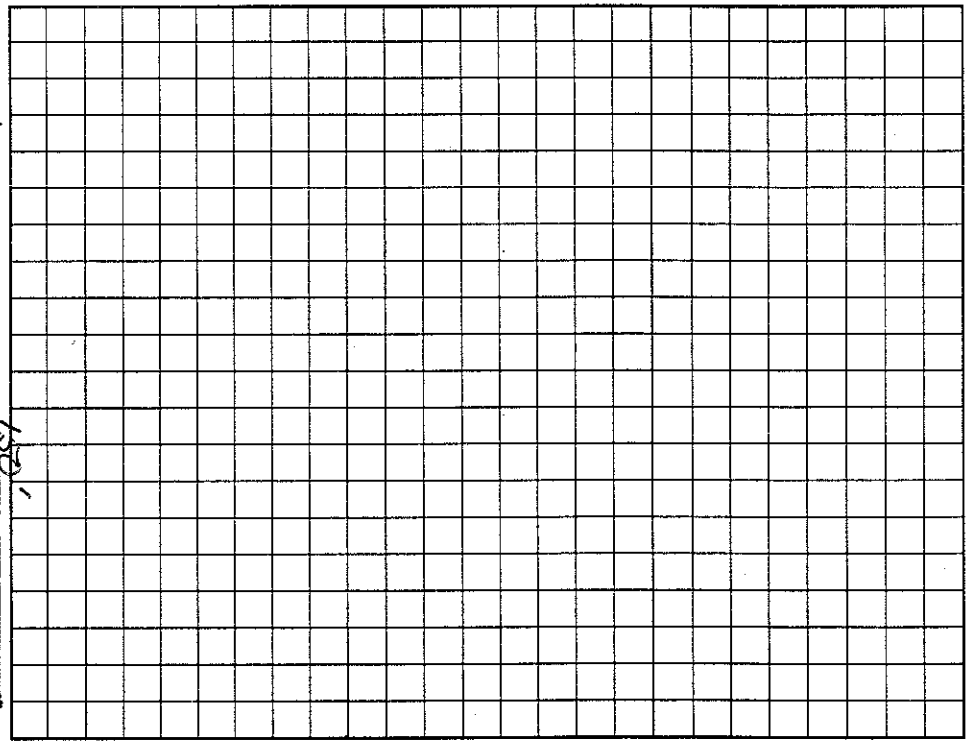

Permit can be suspended or revoked if any false information is supplied toward securing the permit/any unauthorized changes are made to the site/any unauthorized changes are made in the installation of the system. Improvement Permit with plat valid without expiration. Improvement Permit with site plan valid for sixty months. Authorization to Construct is valid for a period equal to that of Improvement Permit – not to exceed sixty months.

Signed: [signature] date 12/22/99 Installed by: A-1 Backhoe

Improvement Permit by: [signature] RS date 12-8-99 Operation Permit by: Wesley Sparks RS. date 6/27/00

Authorization to Construct by: [signature] RS date 12-8-99 Existing System Inspection by: date

HEALTH DEPT. COPY: WHITE OWNER COPY (FINAL): YELLOW OWNER COPY (INITIAL): PINK