9:30 - 9:45

IREDELL COUNTY HEALTH DEPARTMENT

STATESVILLE 704-878-5305 MOORESVILLE 704-664-5281

IMPROVEMENT PERMIT / AUTHORIZATION TO CONSTRUCT / OPERATION PERMIT / EXISTING SYSTEM INSPECTION

PERMIT# 082712 PIN# ~~4761 65 1580 (pt.)~~ 4761-54-3272 DATE Dec. 8, '99

OWNER OR CONTRACTOR Deer Valley Dev Group LLC PHONE: Business 664-9080 Home

ADDRESS 255 Rolling Hills Rd Mooresville

LOCATION I-40 to 115-21 N. TR Oshuatt Amity Rd. TR Brawley Rd on Right

SUBDIVISION Deer Valley BLOCK / SECTION LOT 45 LOT AREA ±.90 Ac SITE CLASS: PS DESIGN FLOW 360 gpd L.T.A.R. ±4

Septic Tank: 1000 Gallons; STB 1012 Date 10/2/99

Pump Tank: Gallons; PT Date

Pump Make: Model Serial No.

Nitrification Field: No Fields 1 Square Feet 900 Linear Feet 580

No Lines 2 Trench Width 36" Trench Bottom Depth 36" Gravel Depth 12"

☑ New System ☐ Repair System Type: I, II, III, IV, V, VI

System Description: GRAVITY CONVENTIONAL

Repair System Description: SAME

Maintenance Agreement Required: ☐ Yes ☑ No

☑ House/Mod. Home No. Bedrooms 3

☐ Mobile Home No. Bathrooms 2

☐ Business No. Employees

☐ Other


☐ Slab ☑ Crawl Space ☐ Basement w/plumbing ☐ Basement wo/plumbing

Water Supply: ☑ Individual ☐ Public ☐ Community


Comments:/Conditions: INSTALL trenches AT 36" treated bottom depth.
MAINTAIN 100' minimum septic system & well separation

Comments:/Conditions:

INITIAL SITE SKETCH

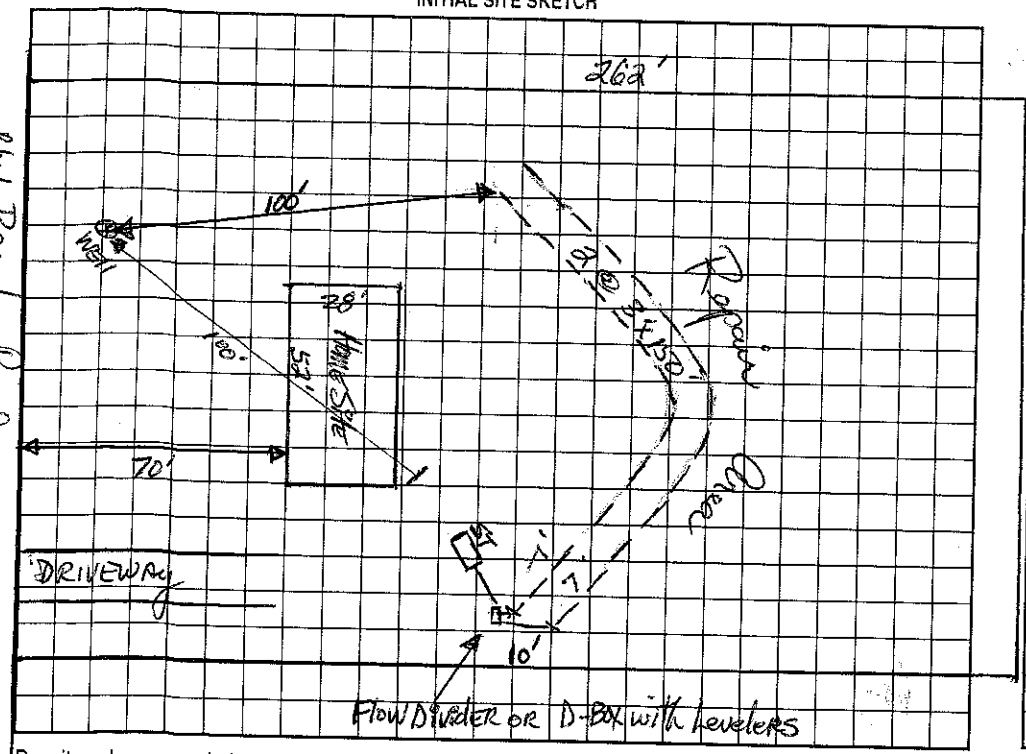

AS BUILT SKETCH

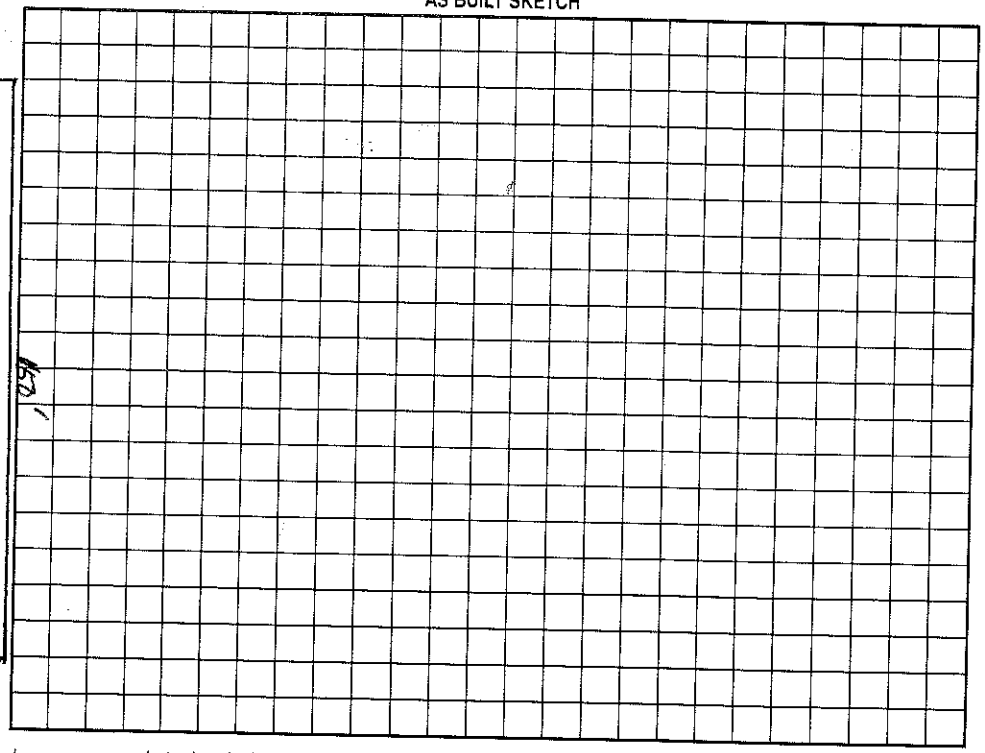

Permit can be suspended or revoked if any false information is supplied toward securing the permit/any unauthorized changes are made to the site/any unauthorized changes are made in the installation of the system. Improvement Permit with plat valid without expiration. Improvement Permit with site plan valid for sixty months. Authorization to Construct is valid for a period equal to that of Improvement Permit – not to exceed sixty months.

Signed: date 12/22/99 Installed by: A-1 Backhoe

Improvement Permit by: Mark R. Thomas, RS date 12-8-99 Operation Permit by: Wesley Sparks R.S. date 2/3/00

Authorization to Construct by: Mark R. Thomas, RS date 12-8-99 Existing System Inspection by: date

HEALTH DEPT. COPY: WHITE OWNER COPY (FINAL): YELLOW OWNER COPY (INITIAL): PINK