IREDELL COUNTY HEALTH DEPARTMENT

STATESVILLE 704-878-5305 50.00 Paid MOORESVILLE 704-664-5281

IMPROVEMENT PERMIT / AUTHORIZATION TO CONSTRUCT / OPERATION PERMIT / EXISTING SYSTEM INSPECTION

PERMIT# 103726 PIN# 4761-54-4318 DATE 12/17/01

OWNER OR CONTRACTOR Eric Rogers PHONE: Business _____ Home 662-8456

ADDRESS PO Box 1101 Mooresville NC 28115

LOCATION 115N, TR Shinnville, TL Blowley 2nd on Lt From Oswalt Amity

SUBDIVISION Deer Valley BLOCK / SECTION 1 LOT 53 LOT AREA 1.01 AC SITE CLASS. P5 DESIGN FLOW 360 L.T.A.R. 0.25

Septic Tank: 1000 Gallons; STB 10 x 2 Date 3/17/01
Pump Tank: _____ Gallons; PT _____ Date _____
Pump Make: _____ Model _____ Serial No. _____
Nitrification Field: No Fields 1 Square Feet 1440 Linear Feet 480
No Lines 5@96' Trench Width 36" Max Trench Bottom Depth 36" Gravel Depth 12"

☒ New System ☐ Repair System Type: I (II) III. IV. V. VI
System Description: Gravity Conventional
Repair System Description: Same
Maintenance Agreement Required: ☐ Yes ☒ No

☐ House/Mod. Home No. Bedrooms 3
☒ Mobile Home No. Bathrooms 2
☐ Business No. Employees _____
☐ Other _____


☐ Slab ☒ Crawl Space ☐ Basement w/plumbing ☐ Basement wo/plumbing

Water Supply: ☒ Individual ☐ Public ☐ Community


Comments:/Conditions: Install lines on Contour

Comments:/Conditions:

INITIAL SITE SKETCH 1"=50'

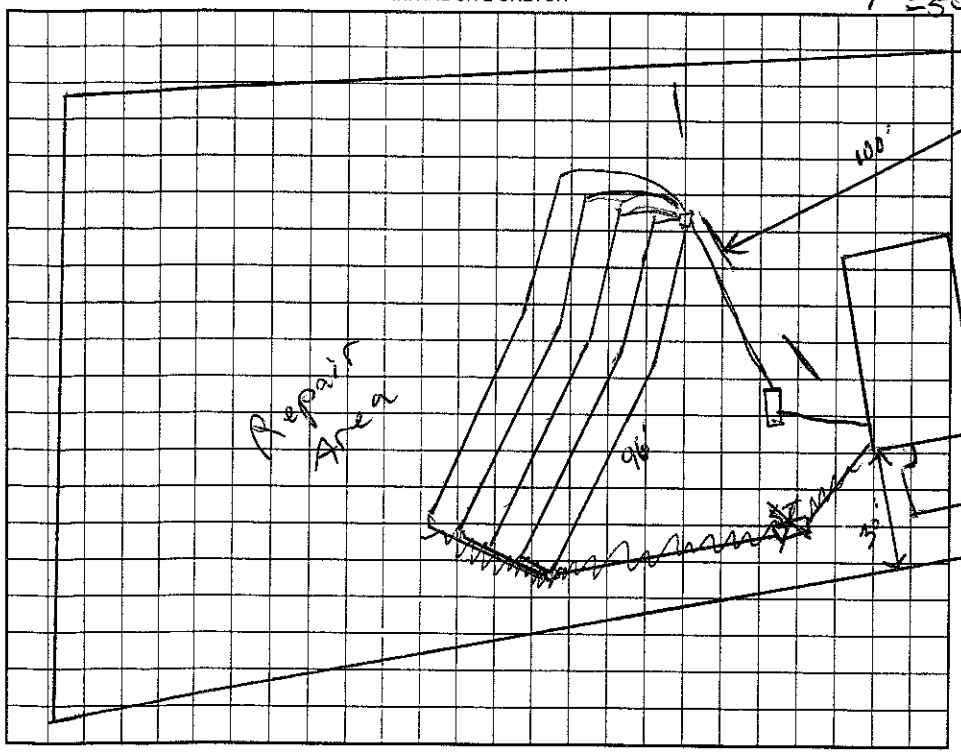

AS BUILT SKETCH

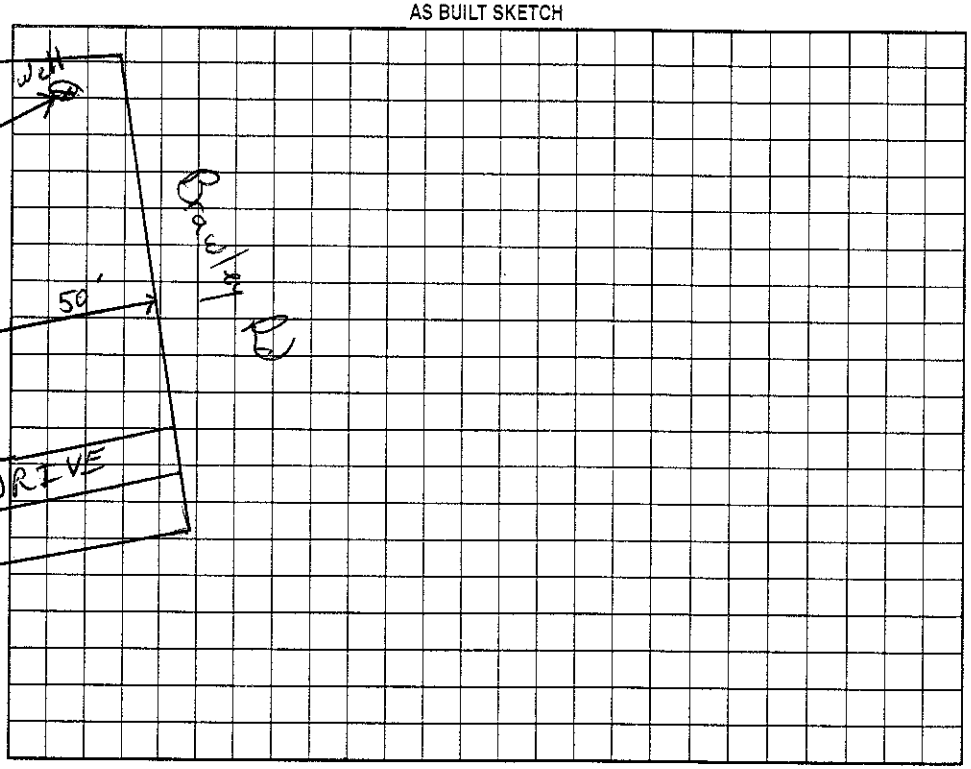

Permit can be suspended or revoked if any false information is supplied toward securing the permit/any unauthorized changes are made to the site/any unauthorized changes are made in the installation of the system. Improvement Permit with plat valid without expiration. Improvement Permit with site plan valid for sixty months. Authorization to Construct is valid for a period equal to that of Improvement Permit – not to exceed sixty months.

Signed Karl Sprinkle date 12-28-01 Installed by: A-1 Backhoe

Improvement Permit by: RSI date 12/17/01 Operation Permit by: RS date 12/31/01

Authorization to Construct by: RSI date 12/17/01 Existing System Inspection by: _____ date _____

HEALTH DEPT. COPY: WHITE OWNER COPY (FINAL): YELLOW OWNER COPY (INITIAL): PINK