$50 11:30

IREDELL COUNTY HEALTH DEPARTMENT

STATESVILLE 704-878-5305 MOORESVILLE 704-664-5281

IMPROVEMENT PERMIT / AUTHORIZATION TO CONSTRUCT / OPERATION PERMIT / EXISTING SYSTEM INSPECTION

PERMIT# 103 725 PIN# 4761-54-4581 DATE 2/1/02

OWNER OR CONTRACTOR Paul Sprinkle PHONE: Business 704-662-8436 Home

ADDRESS PO Box 1101 Mooresville NC 28115

LOCATION I-5N, TR Shinnville, TL Brawley on Corner W/ Oswalt Family

SUBDIVISION Deer Valley BLOCK / SECTION 1 LOT 52 LOT AREA 1.04 Ac SITE CLASS. PS DESIGN FLOW 360 L.T.A.R. .05

Septic Tank: 1000 Gallons; STB 1012 Date 10/13/01

Pump Tank: Gallons; PT Date

Pump Make: Model Serial No.

Nitrification Field: No Fields 1 Square Feet 1200 Linear Feet 400

No Lines 6@67 Trench Width 36" Max Trench Bottom Depth 36" Gravel Depth 12"

☒ New System ☐ Repair System Type: I (II) III IV V VI

System Description: Gravity Conventional

Repair System Description: Same

Maintenance Agreement Required: ☐ Yes ☒ No

☐ House/Mod. Home ☒ Mobile Home ☐ Business ☐ Other

No. Bedrooms 3 No. Bathrooms 2 No. Employees

☐ Slab ☒ Crawl Space ☐ Basement w/plumbing ☐ Basement wo/plumbing

Water Supply: ☒ Individual ☐ Public ☐ Community


Comments:/Conditions:

Install Drain Lines on Contour - Keep 100' from wells

Comments:/Conditions:

1"=50'

INITIAL SITE SKETCH

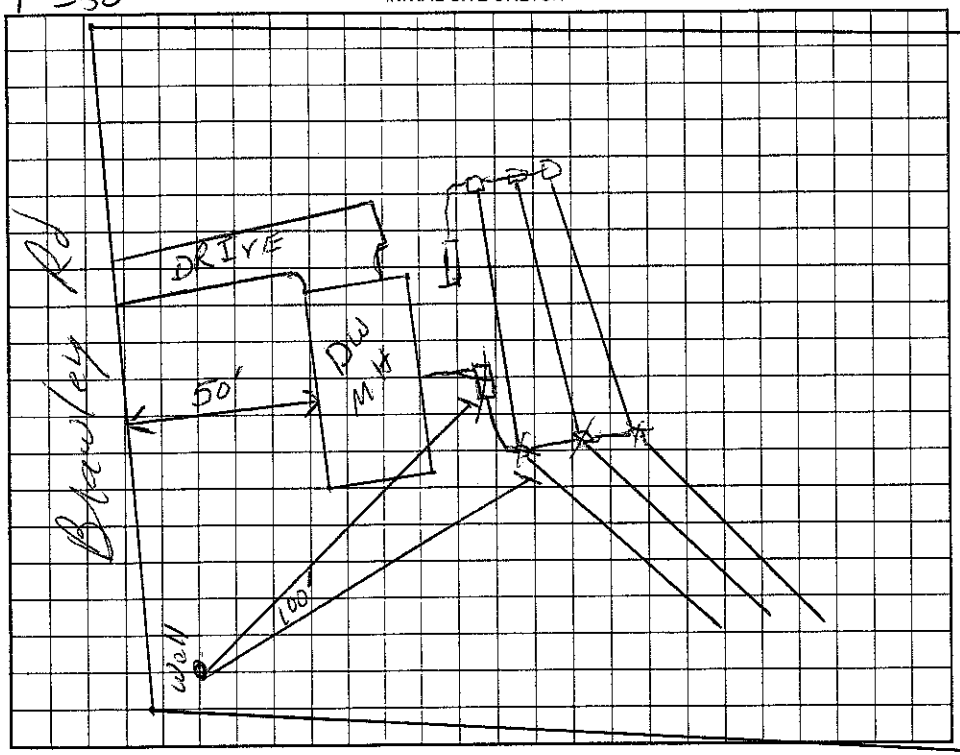

AS BUILT SKETCH

Permit can be suspended or revoked if any false information is supplied toward securing the permit/any unauthorized changes are made to the site/any unauthorized changes are made in the installation of the system. Improvement Permit with plat valid without expiration. Improvement Permit with site plan valid for sixty months. Authorization to Construct is valid for a period equal to that of Improvement Permit – not to exceed sixty months.

Signed: Dennis Dahl date

Improvement Permit by: RS date 2/4/02

Authorization to Construct by: RS date 2/4/02

Installed by: A-1 Backhoe

Operation Permit by: RS date 2/5/02

Existing System Inspection by: date

HEALTH DEPT. COPY: WHITE OWNER COPY (FINAL): YELLOW OWNER COPY (INITIAL): PINK