50.00 Paid

IREDELL COUNTY HEALTH DEPARTMENT

STATESVILLE 704-878-5305 MOORESVILLE 704-664-5281

IMPROVEMENT PERMIT / AUTHORIZATION TO CONSTRUCT / OPERATION PERMIT / EXISTING SYSTEM INSPECTION

PERMIT# 106208/12140 PIN# ~~4766545858~~ 57 4761-54-7617 DATE 6/10/04

OWNER OR CONTRACTOR Schult Housing Advantage PHONE: Business 704-902-1836 Home

ADDRESS 134 KOA La Statesville NC 28677

LOCATION 115 N, TR Shinnville, TL Brawley, on RT Near End

SUBDIVISION Deer Valley BLOCK / SECTION 4 LOT 57 LOT AREA 0.967 Ac SITE CLASS. PS DESIGN FLOW 360 L.T.A.R. 0.25

Septic Tank: 1000 Gallons; STB 10/2 Date 1/18/04
Pump Tank: Gallons; PT Date
Pump Make: Model Serial No.
Nitrification Field: No Fields 1 Square Feet 1440 Linear Feet 480
No Lines 6@80' Trench Width 36" Max Trench Bottom Depth 24" Gravel Depth 12"

☒ New System ☐ Repair System Type: I (II) III, IV, V, VI
System Description: Gravity Conventional
Repair System Description: Gravity 25% Red/LAP
Maintenance Agreement Required: ☐ Yes ☒ No


☒ House/Mod. Home No. Bedrooms 3
☐ Mobile Home No. Bathrooms 2
☐ Business No. Employees
☐ Other
☐ Slab ☒ Crawl Space ☐ Basement w/plumbing ☐ Basement wo/plumbing

Water Supply: ☒ Individual ☐ Public ☐ Community


Comments:/Conditions:

Comments:/Conditions:

INITIAL SITE SKETCH

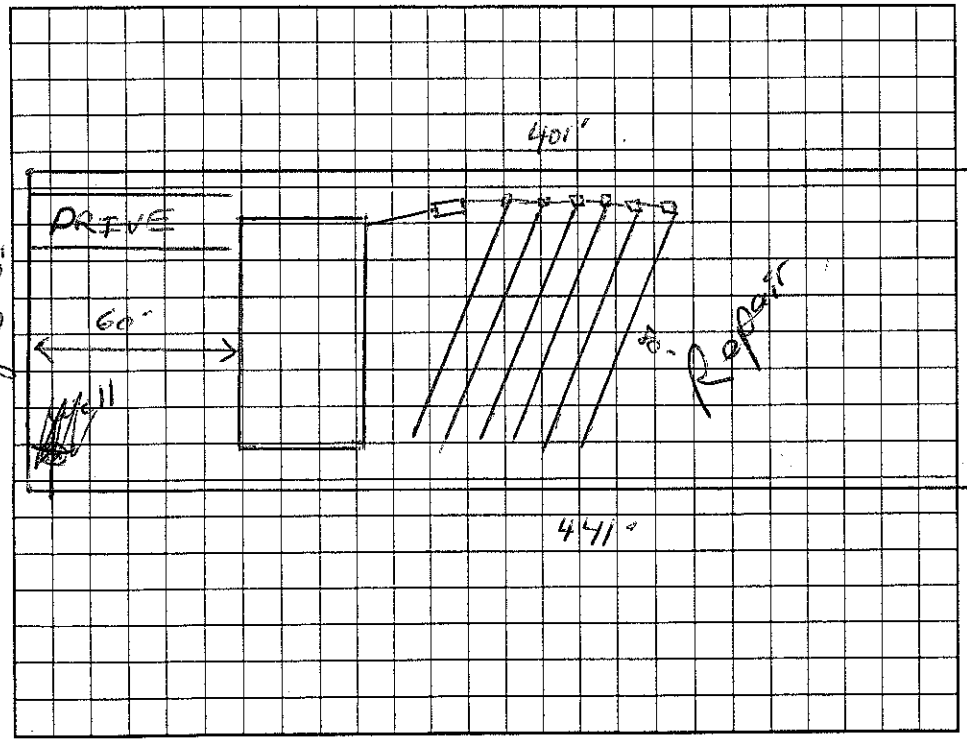

AS BUILT SKETCH

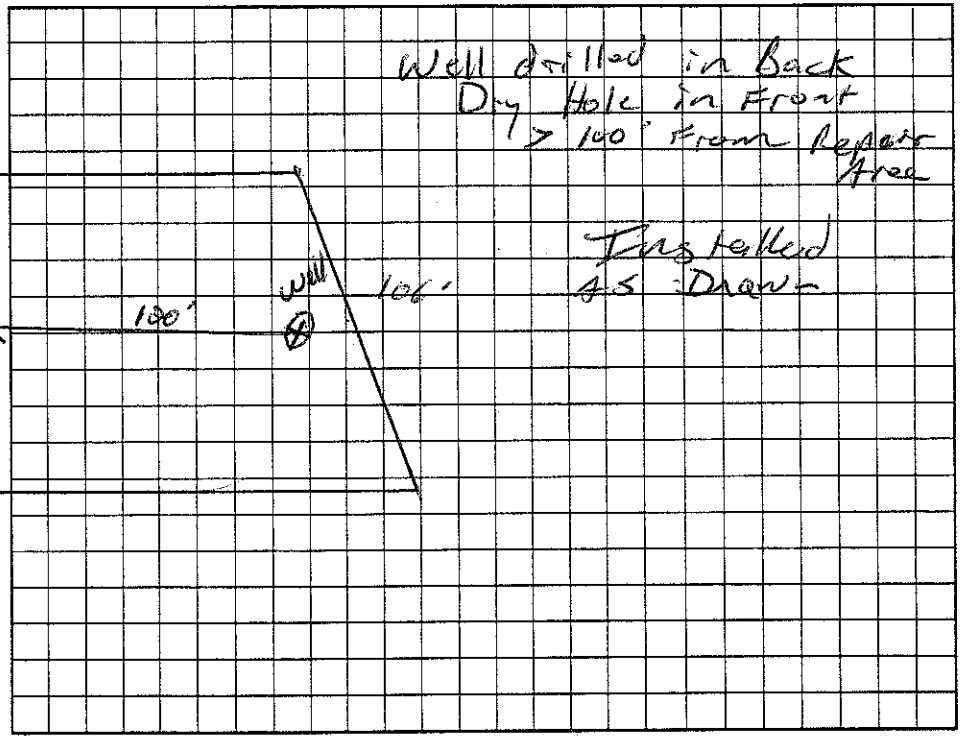

Permit can be suspended or revoked if any false information is supplied toward securing the permit/any unauthorized changes are made to the site/any unauthorized changes are made in the installation of the system. Improvement Permit with plat valid without expiration. Improvement Permit with site plan valid for sixty months. Authorization to Construct is valid for a period equal to that of Improvement Permit – not to exceed sixty months.

Signed: Jerald C Smith date 11 June 04 Installed by: A-1 Backhoe

Improvement Permit by: RS date 6/10/04 Operation Permit by: RS date 6/15/04

Authorization to Construct by: RS date 6/10/04 Existing System Inspection by: date

HEALTH DEPT. COPY: WHITE OWNER COPY (FINAL): YELLOW OWNER COPY (INITIAL): PINK