IREDELL COUNTY HEALTH DEPARTMENT

STATESVILLE 704-878-5305 (1) MOORESVILLE 704-664-5281

IMPROVEMENT PERMIT / AUTHORIZATION TO CONSTRUCT / OPERATION PERMIT / EXISTING SYSTEM INSPECTION

PERMIT# 106202 PIN# ~~4761654158055~~ 4761-54-7286 DATE 5/28/02

OWNER OR CONTRACTOR LEADER HOMES PHONE: Business _____ Home _____

ADDRESS _____

LOCATION ~~BRAWLEY~~ OSWALT AMITY - TR BRAWLEY - 2nd on LT

SUBDIVISION DEERVALLEY BLOCK / SECTION 4 LOT 55 LOT AREA .788AC SITE CLASS. PS DESIGN FLOW 360GPD L.T.A.R. .30GPD/Ft²

Septic Tank: 1000 Gallons; STB 1012 Date 4/23/02
Pump Tank: _____ Gallons; PT _____ Date _____
Pump Make: _____ Model _____ Serial No. _____
Nitrification Field: No Fields 1 Square Feet 1200 Linear Feet 400
No Lines 6@67' Trench Width 36" Max Trench Bottom Depth 36" Gravel Depth 12"

☑ New System ☐ Repair System Type: I (II) III. IV. V. VI
System Description: GRAVITY CONVENTIONAL
Repair System Description: SAME
Maintenance Agreement Required: ☐ Yes ☑ No

~~☑~~ House/Mod. Home No. Bedrooms 3
☑ Mobile Home No. Bathrooms 3
☐ Business No. Employees ____
☐ Other _____


☐ Slab ☑ Crawl Space ☐ Basement w/plumbing ☐ Basement wo/plumbing

Water Supply: ~~☑~~ Individual ☐ Public ☐ Community


Comments:/Conditions:

Comments:/Conditions:

INITIAL SITE SKETCH

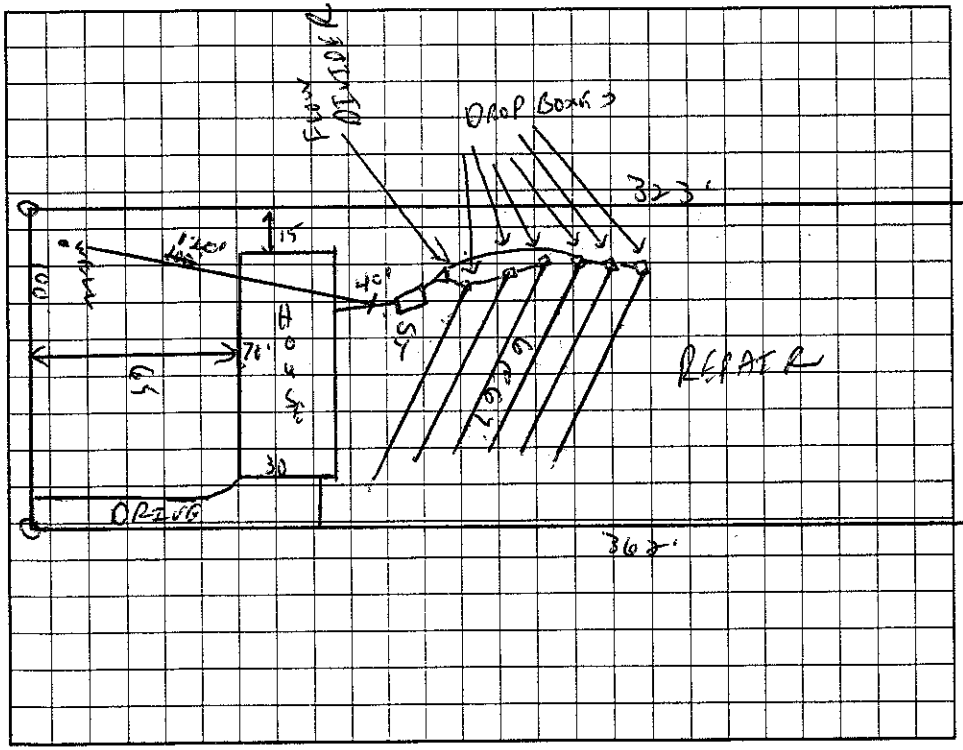

AS BUILT SKETCH

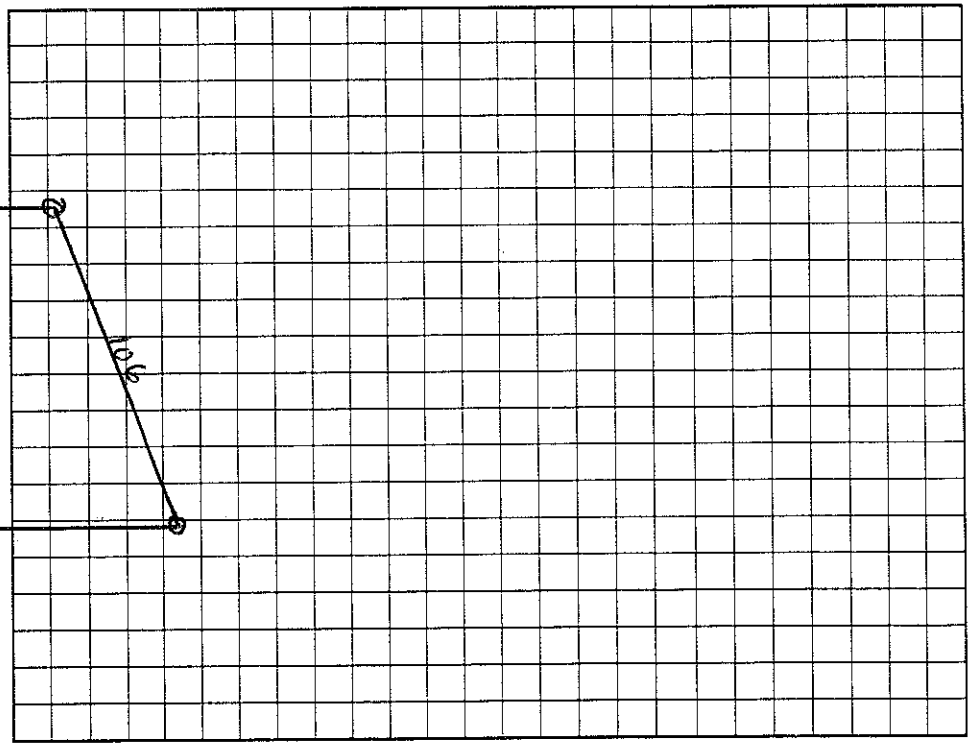

BRAWLEY RD

Permit can be suspended or revoked if any false information is supplied toward securing the permit/any unauthorized changes are made to the site/any unauthorized changes are made in the installation of the system. Improvement Permit with plan valid without expiration. Improvement Permit with site plan valid for sixty months. Authorization to Construct is valid for a period equal to that of Improvement Permit – not to exceed sixty months.

Signed: Tracy S Poole date 5/28/02 Installed by: A-1 Backhoe

Improvement Permit by: C. [illegible] RS date 5/28/02 Operation Permit by: Wesley Sparks RS. date 9/10/02

Authorization to Construct by: C. [illegible] RS date 5/28/02 Existing System Inspection by: _____ date _____

HEALTH DEPT. COPY: WHITE OWNER COPY (FINAL): YELLOW OWNER COPY (INITIAL): PINK